

WATER SERVICE RECORD

Name Richard D. Hamilton

Service No. 33

Address 25 Harbell Street

432

Location

~~XXXXXX~~ ~~Repair~~ ~~Renewal~~ ~~XXXXXX~~ New Service


Comm 5-4-59

Date	Material	Amount	Total	Date		Amount
4-9-59	Labor	3.77		4-8-59	Deposit P	100.00
	10% O.H.	.38	4.15	5-4-59	Retained	75.33
	38' 3/4" Copper tubing @ .3666		13.93			24.67
	1 3/4" C x 1/2 I.W.H. Stop & Waste		5.84		NON CHARGE	
	1 hr. Trucking @ .75		.75		Labor	20.12
			24.67			
				7'	3/4" Copper tubing @ .3666	2.57
				1	3/4" C Corp Cock	4.64
				1	3/4" C Curb Cock	6.03
				1	Box & Rod	5.00
				1	1/2 Straight tailpiece	.50
				1	1/2 Offset tailpiece	.50
				1	hr. Town Shovel @ 6.50	6.50
						45.86

DATE _____

TOWN OF LEXINGTON — BOARD OF PUBLIC WORKS
WATER DIVISION

Sketch of Service Here

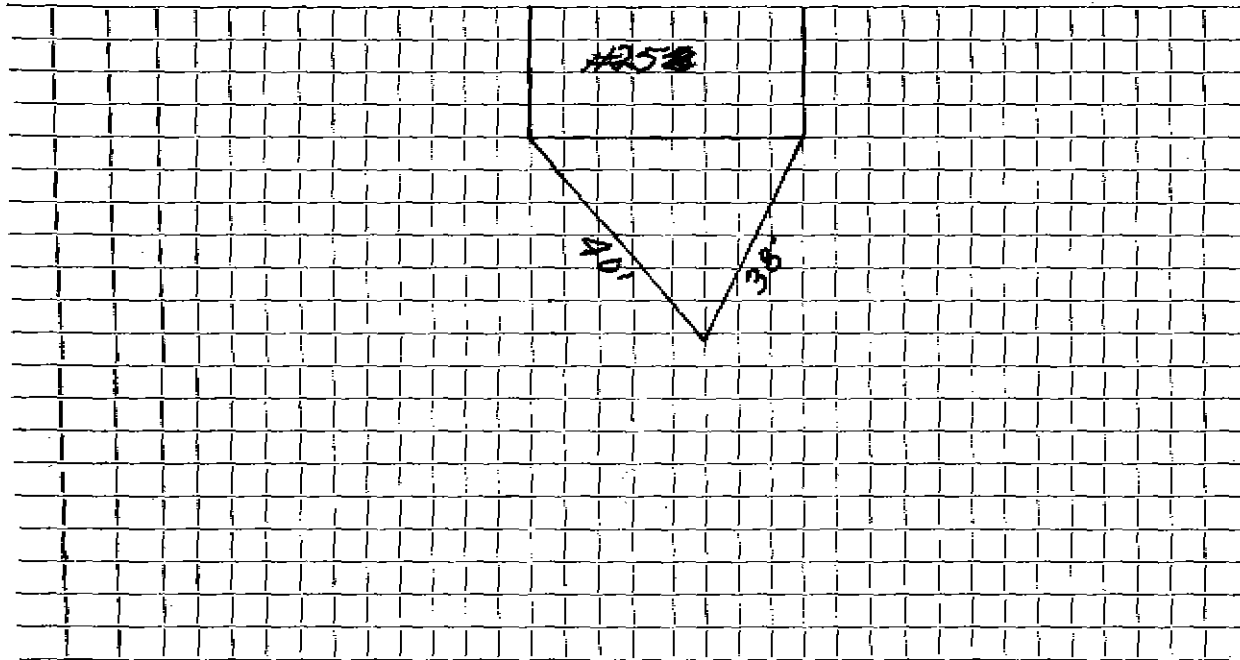

Connection made in Street. Work completed

Remarks:

.....

.....