

WATER SERVICE RECORD

Name William Hamilton

Service No. 214

Address 28 Harbell Ave.

Location

~~Repair~~ ~~Renewal~~ New Service


Comm. 12-9-57

Date	Material	Amount	Total	Date	Amount
9/30/57	labor	2 15		9-26-57	Deposit \$ 35 00
	10% overhead	22		12-2-57	Refund 13 04
			2 37		NON CHARGE \$ 21 96
	37' 3/4" copper tubing @.375		13 88		labor 1 53
	1 3/4" Cx 1/2 IWH stop & waste		4 96		22' 3/4" copper tubing @.375 8 25
	1 hr. trucking @ .75		75		1 3/4" C corp cock 4 64
			21 96		1 3/4" C curb cock 5 94
					1 box & rod 4 62
					1 1/2 straight tail pc. 50
					1 1/2 offset tail pc. 50
					25 98
				8-15-91	23' 3/4" Copper
					1 3part compression union
					1 3/4" compression corp

TOWN OF LEXINGTON — BOARD OF PUBLIC WORKS

WATER DIVISION

Sketch of Service Here

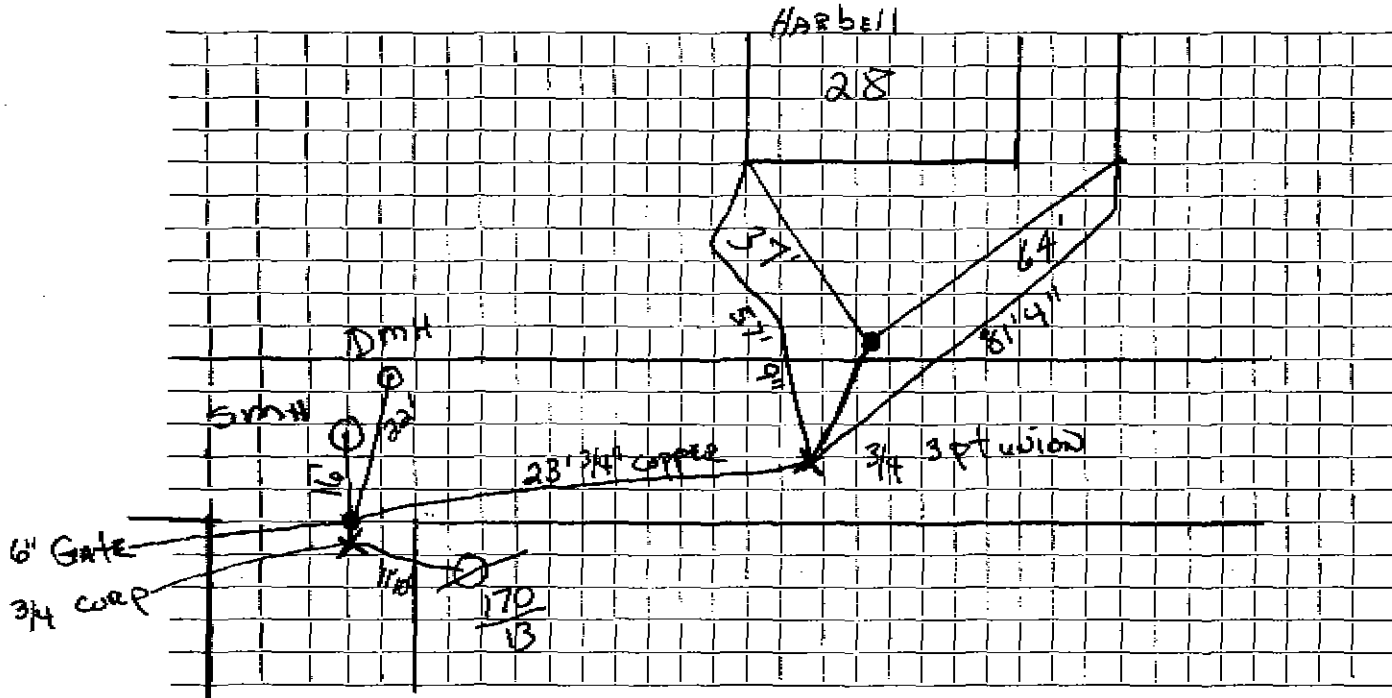

Connection made in Street. Work completed

Remarks: Aug. 15, 1991 Copper disconnected from old dead end main
 and tapped on re-lined main on Balfour