

Name Orrin Dyer

Service No. 1187

Address 6 Grove Street, Reading
15 Harding Rd.

Location ¹⁵ Harding Road, Lexington

Kind of Pipe

Size

Size of Main

~~Repair - Renewal~~ - New Service

, Location

Date	Material	Amount
1936		
July 21	3 hrs. labor @ 60¢	1 80
<i>Comp. 1/6.00 to Russell 8-4-36</i>	5 " " @ 55¢	<u>2 75</u>
	10% Ovhd. on labor	45
	32' 3/4" Copper Tub. @ 15¢	4 80
	1 Stop & Waste	1 75
	Trucking	<u>1 50</u>
	Chge.: 32' @ 50¢ - \$16.00	

Total
4 55
45
<u>8 05</u>
13 05
<u>16 00</u>

Date

*June 18 1936 Deposited
July 4 1936 Cash
Refunded*

Amount
22 40
6 40
<u>16 00</u>

Labor

DATE 6/7/36

TOWN OF LEXINGTON—BOARD OF PUBLIC WORKS

WATER DIVISION

The undersigned applies for a supply of water at No. Harding Ave St. and hereby agrees to comply with the rules and regulations as now, or at any future time, established by the Board of Selectmen.

Am't. of Estimate \$ 2240


Owner Arvin L Lyster

Am't. Paid \$ 2240

Address 6 Grove St Reading

Builder _____

Sketch of Service Here

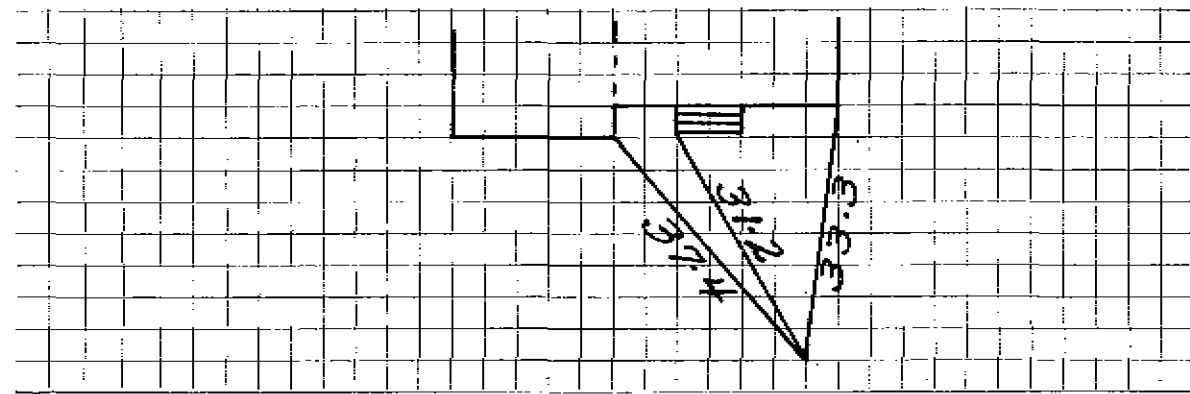

Connection made in _____ Street. Work completed _____ 19

Remarks: