


DATE _____

TOWN OF LEXINGTON — BOARD OF PUBLIC WORKS

WATER DIVISION

Sketch of Service Here

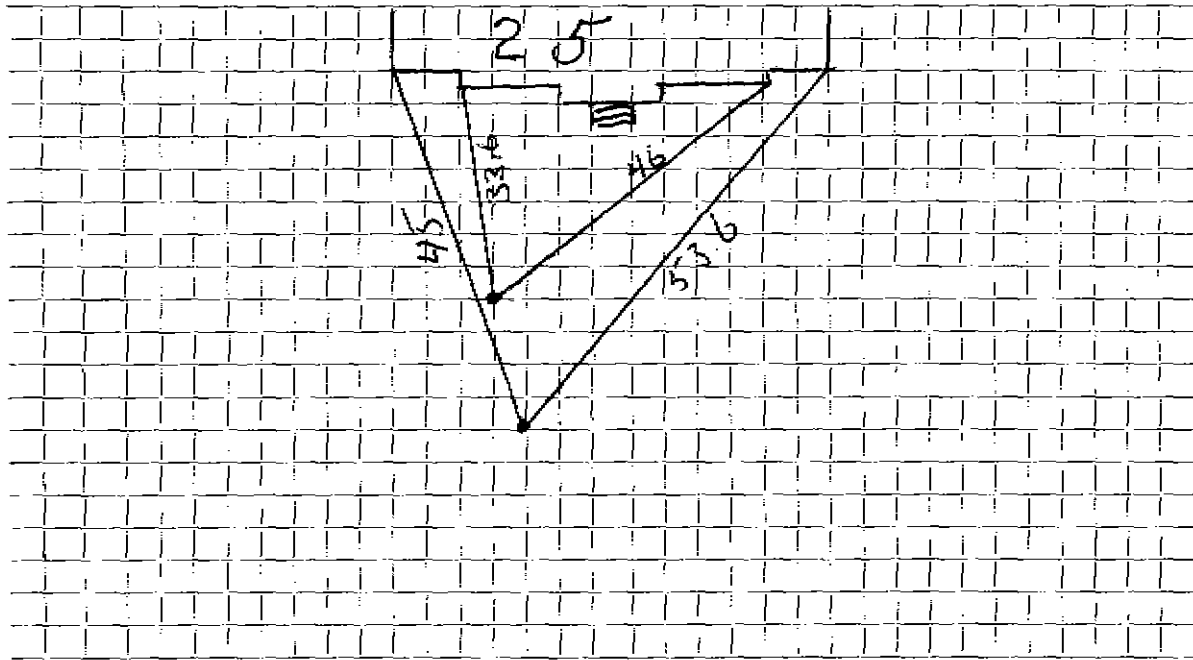

Connection made in Street. Work completed ... 5-8-90

Remarks: .. Sewer .. in same trench .. 2' to right of water as you look @ house