

Name

Address 27 Harding Rd.

Service No. 1190
#5299

Location 27 Harding Rd.

Kind of Pipe

Size

Size of Main

~~Repair~~ Renewal ~~New Service~~

Location

Date

Material

Amount

Total

Date

Amount

4/15/77

7'	3/4" copper				
1	3/4" X 5/8" lead to copper LF adpt.				
1	1" style 138				
1	1" X 6" nipple				
1	3/4" copper curb				
1	ton cold patch				
	Trench 8 by 10				

Labor

TOWN OF LEXINGTON—BOARD OF PUBLIC WORKS

WATER DIVISION

The undersigned applies for a supply of water at No. _____ St. and hereby agrees to comply with the rules and regulations as now, or at any future time, established by the Board of Selectmen.

Am't. of Estimate \$ _____


Owner E. Brehant

Am't. Paid \$ _____

Address 27 ~~29~~ Harding Rd.

Builder _____

Sketch of Service Here

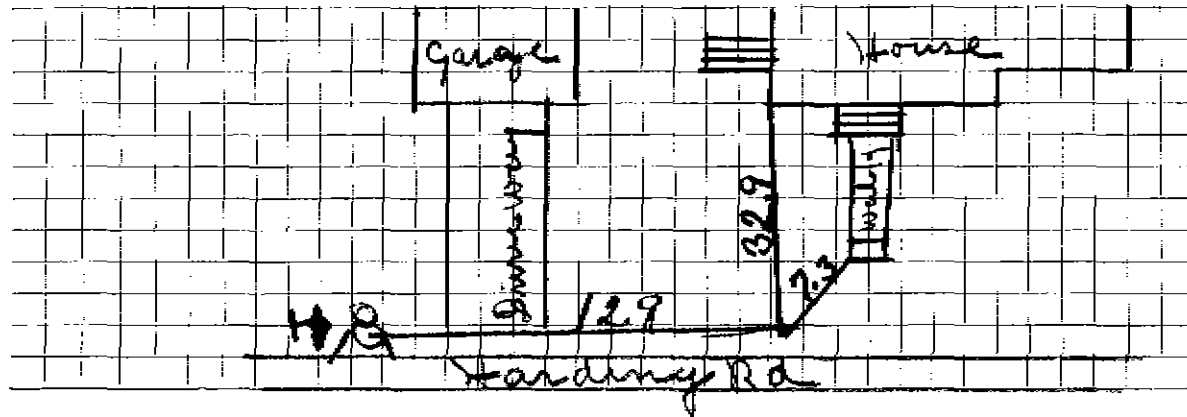

Connection made in _____ Street. Work completed _____ 19

Remarks: