

WATER SERVICE RECORD

Name Bessi M. Mellen

Service No. 48

Address 28 Harding Rd. Lexington, Mass.

Location

Repair—Renewal—New Service #3820


Date	Material	Amount	Total	Date	Amount
10/10/75	labor	42. 58		10/15/75	Deposit 250. 00
	10% OH	4. 26	46. 84	8/16/76	Refund 144. 58
35'	3/4" copper tubing @ .67		23. 45		105. 42
1/2 yd.	loam		3. 00		
2 lbs.	seed @ .35		. 70	10-15-75	
1	3/4" wheel stop		15. 43	21'	3/4 Copper
2 hrs.	shovel @ 6.50		13. 00	1	3/4 Curb
1 hr.	truck @ 3.00		3. 00	1	Box + Red
			105. 42		

DATE _____

TOWN OF LEXINGTON — BOARD OF PUBLIC WORKS

WATER DIVISION

Sketch of Service Here

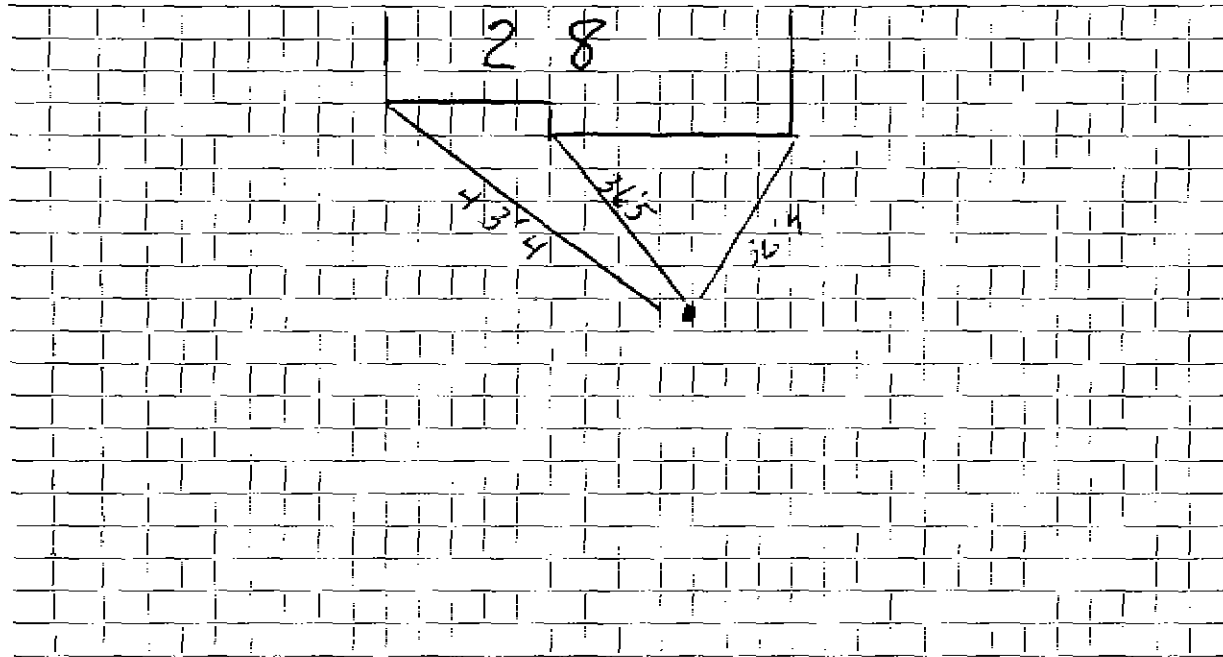

Connection made in Street. Work completed

Remarks:
.....
.....