

Name John Plugis
 Address Arch Street, Billerica
 29 Harding Rd.

Service No. ~~74~~ 1192
 #5287

Location 29 Harding Road

Kind of Pipe

Size

Size of Main

Repair—Renewal—New Service

Location

Date
 1939

Material

Amount

Total

Date

Amount

Dec. 5 1 hr. @ 60¢ 60
 Com. r. 39 1 " @ 65¢ 65
 10% Overhead
 37' 3/4" Copper tubing @ 16¢
 1 3/4" C/x 1/2" I.S.& W.
 1 3/4" C.Union (3 part)
 1 hr. trucking @ 75¢
 Trench repairs

				December 4, 1939	Deposited	19.00
			1 25	December 2, 1939	Refunded	5.29
						13.71
					KOR CHARGE (Repair)	
				3-28-62	Labor	8.64
					1 Curb Box & Rod	4.90
					1 hr. Town Shovel @6.50	6.50
			2 66			
			13 71			20.04

Labor

1/2
3/4
1/2
1/4
1/8
1/16
1/32
1/64
1/128
1/256
1/512
1/1024

DATE December 5 1939

TOWN OF LEXINGTON—BOARD OF PUBLIC WORKS

WATER DIVISION

The undersigned applies for a supply of water at No. 29 Harding Road St. and hereby agrees to comply with the rules and regulations as now, or at any future time, established by the Board of Selectmen.

Pho-gis

Am't. of Estimate \$ 19⁰⁰

Owner

John A. Pho-gis
Orch. Billerica


Am't. Paid \$ _____

Address

Builder _____

Trench already dug

Sketch of Service Here

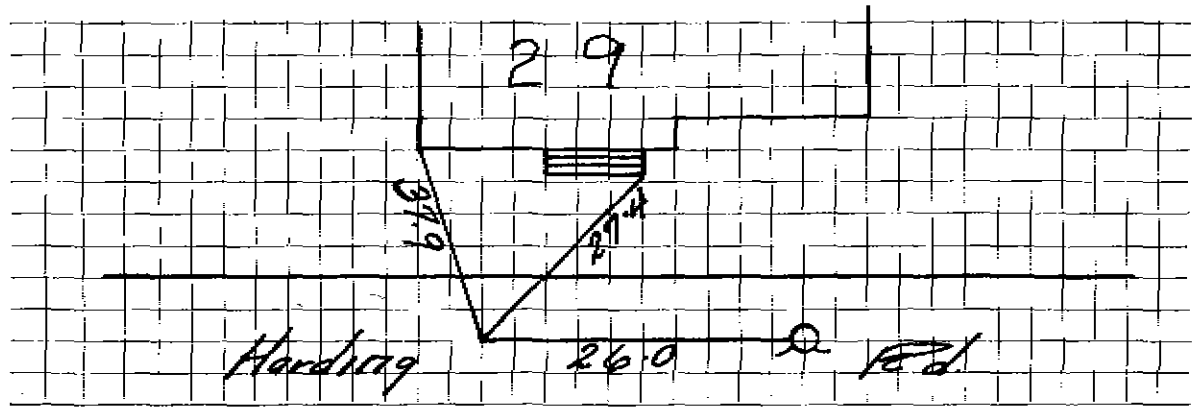

Connection made in _____

Street.

Work completed _____

19

Remarks: