


Date: 2/6/24

TOWN OF LEXINGTON - BOARD OF PUBLIC WORKS
WATER DIVISION

SKETCH OF SERVICE HERE
30 Harding Rd

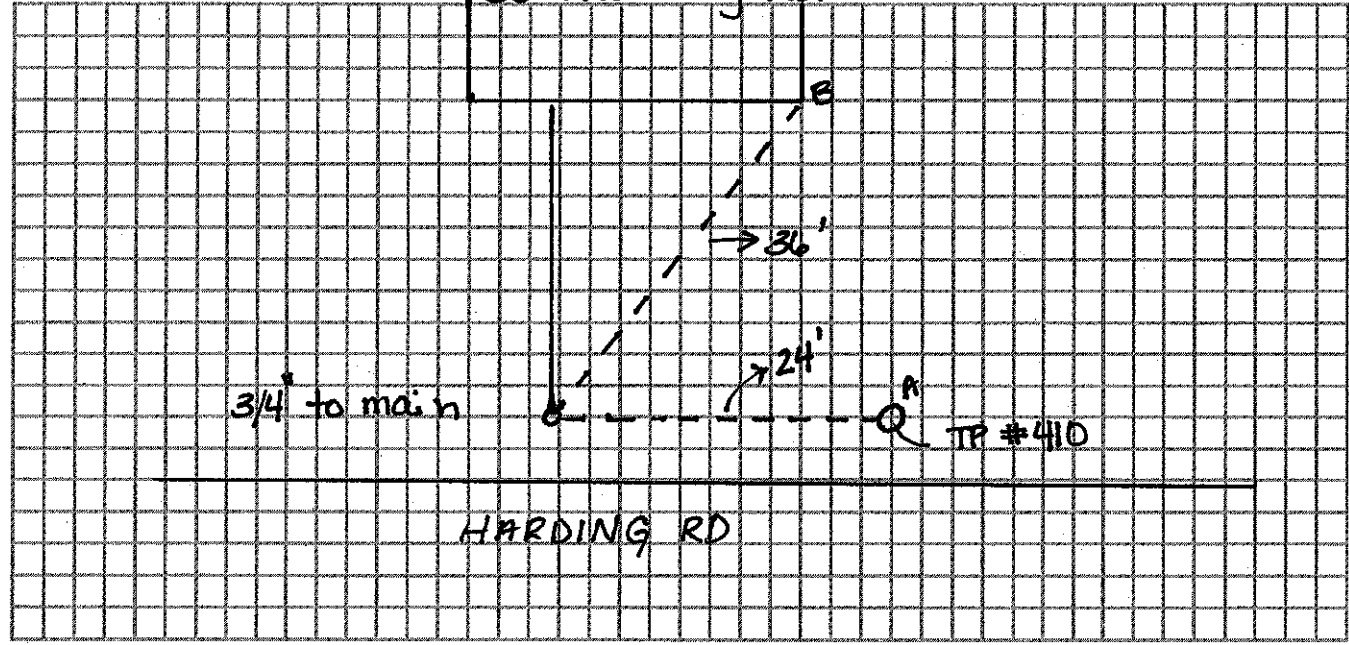

Connection made in: _____ Street: _____ Work completed: _____
Remarks: McLaughlin, James M. Inc.