

Name John Flugis

Service No. # 1194
3130

Address Arch Street, Billerica, Mass.
31 Harding Rd.

Location 31 Harding Road

Kind of Pipe

Size

Size of Main

Repair—Renewal—New Service

Location

Date

Material

Amount

Total

Date

Amount

Oct. 22, 1940 8 hrs. @ 60¢ 4 80

Com. 31-40 10% Overhead 48

36' 3/4" Copper tubing @ 19¢ 6 84

1 3/4" C.S. & W. 2 25

1 hr. trucking @ 75¢ 75

Trench repairs 2 00

17 12

Oct. 24, 1940 Deposited
Dec 31, 1940 Refund -

19 00
188
17 12

Labor

DATE Oct 14 1940

TOWN OF LEXINGTON—BOARD OF PUBLIC WORKS
WATER DIVISION

The undersigned applies for a supply of water at No. 31 Harding Rd St. and hereby agrees to comply with the rules and regulations as now, or at any future time, established by the Board of Selectmen.

Am't. of Estimate \$ _____


Owner Edward Plegis

Am't. Paid \$ _____

Address 31 Harding road

Builder John Plegis Arch St Bellerica

Sketch of Service Here

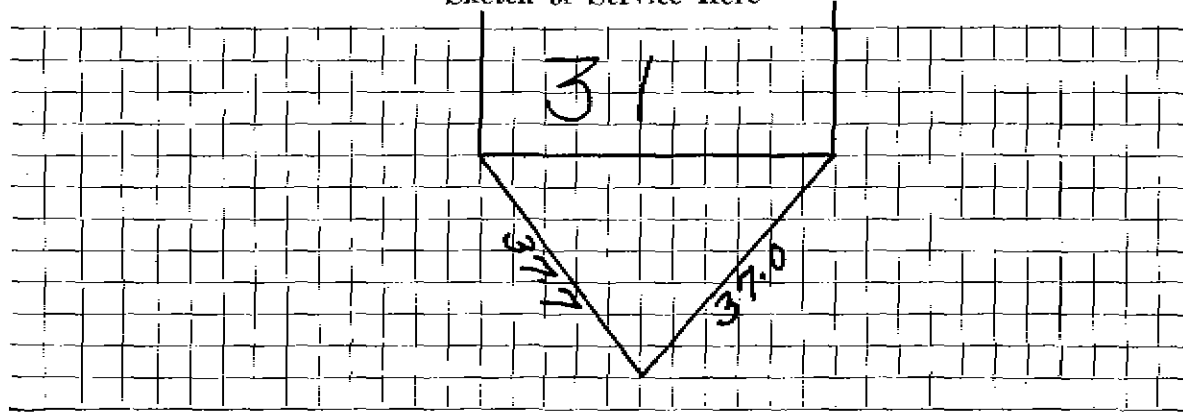

Connection made in _____ Street.

Work completed _____ 19

Remarks: