

WATER SERVICE RECORD

Name _____

Service No.

Address 37 Harding Rd

Location


Repair—Renewal—New Service

DATE _____

TOWN OF LEXINGTON — BOARD OF PUBLIC WORKS

WATER DIVISION

Sketch of Service Here

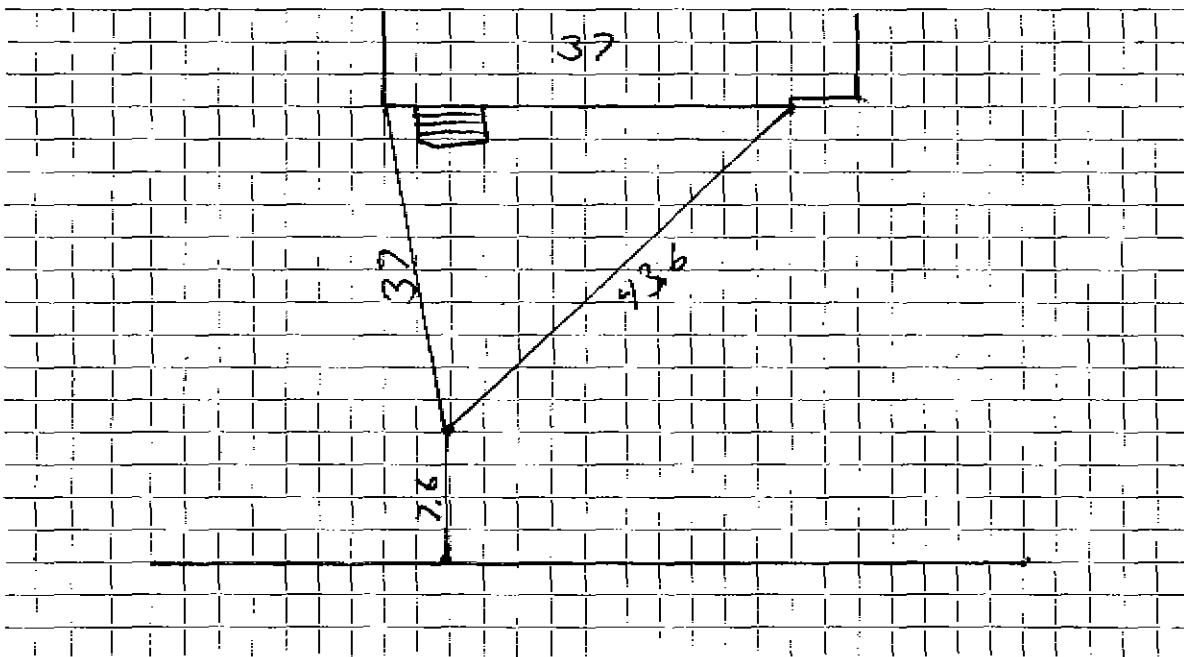

Connection made in Street. Work completed

Remarks: Curb... opens... LEFT ... From Inside
..... Sewer... in... Same trench... as... Water... 6" From water... on... LEFT... as... you... look
... at... house.....