

WATER SERVICE RECORD

Name Steven Krich

Service No. 14

Address 40 Harding Road

Location

~~Repair~~ - ~~Renewal~~ - ~~New Service~~ W.O. #2196.

FEB 10 1975

Date	Material	Amount	Total	Date	Amount
6/14/74	Labor	18.10		6-17-74	150.00
8/19/74	Labor	83.34	101.44	2-27-81	67.04
	10% O.H.	10.14	\$111.59		217.04
36'	3/4" Copper Pipe	@1.05	37.80		
1	3/4" Wheel Valve		11.13		
1	3/4" Copper to Iron Elbow		1.08		
3	Ton Hot Top	@12.15	36.45		
3	Hrs. Trucking	@3.00	9.00		
2	Hrs. Trucking(Pick-up)	@1.50	3.00		
1	Hr. Roller	@2.00	2.00		
1	Hr. Compressor	@5.00	5.00		
			\$217.04		


217.04

DATE _____

TOWN OF LEXINGTON — BOARD OF PUBLIC WORKS

WATER DIVISION

Sketch of Service Here

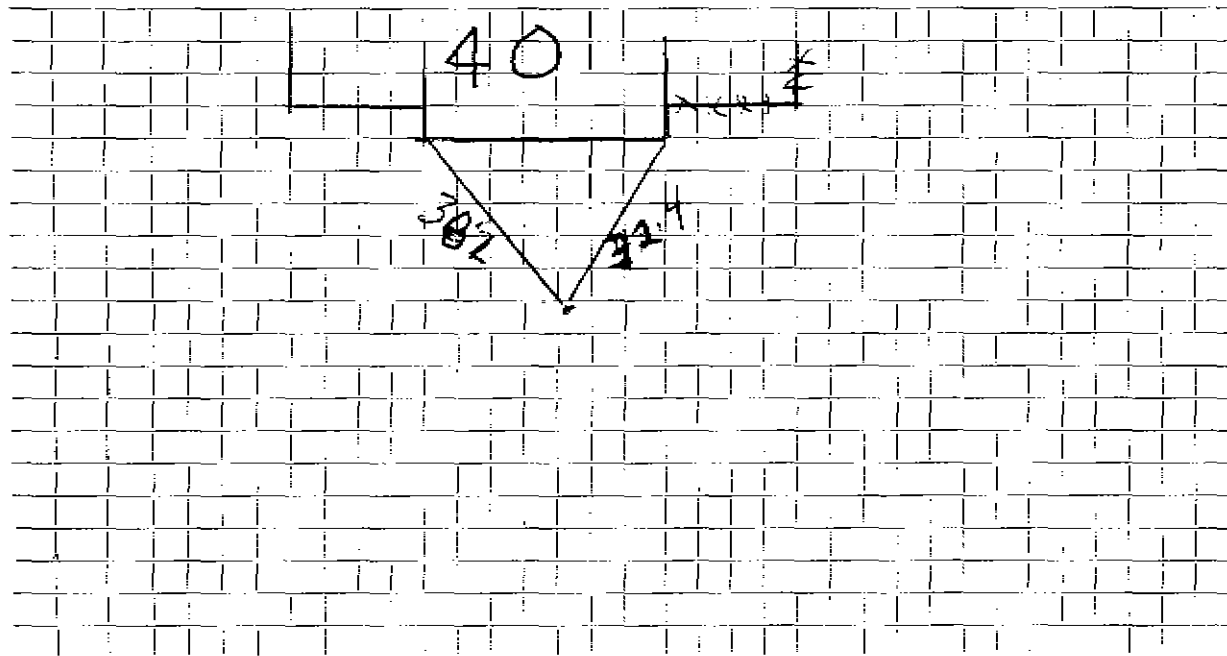

Connection made in Street. Work completed

Remarks:

.....
.....