

WATER SERVICE RECORD

Name Charles Carota

Service No. 28

Address 41 Harding Rd.

Location

~~Repair~~—Renewal—~~New Service~~ WO #4564

Date	Material	Amount	Total	Date	Amount
6/7/76	labor	51. 91		6/7/76	280. 00
	10%OH	5. 19	57. 10	8/16/76	138. 81
	34' 3/4" Copper Tubing @ .65		22. 10		116. 19
1	3/4 X 3/4 Stop and Waste		15. 99	6/7/76	
1	3/4 X 1/2 Brass Bushing		1. 46	11'	labor
1	hr. truck		3. 00	1	3/4" Copper @ .65
2	hr. shovel @ 6.00		13. 00	1	3/4" Curb Stop
			111. 19	1	Corp. adpt.
				1	Box and Rod
				1/2	Ton Patch
					Patch 5' X 6'
					100. 63


*Deposit
Refund*

OUTSIDE

DATE _____

TOWN OF LEXINGTON — BOARD OF PUBLIC WORKS
WATER DIVISION

Sketch of Service Here

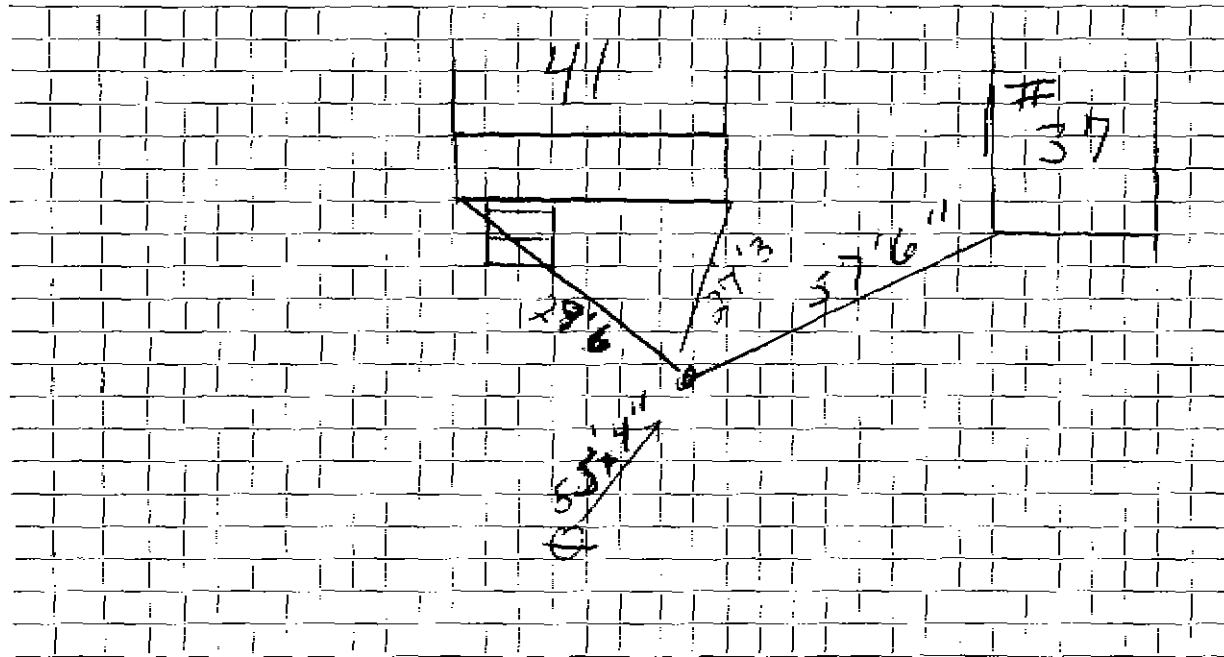

Connection made in Street. Work completed

Remarks:

.....

.....