

WATER SERVICE RECORD

Name N.Y. Brothers Trust

Service No. 76.

Address #42 Harding Road -

Location

~~Repair~~ ~~Renewal~~ - New Service ✓ De Flice Bros. # 2453 W.O. #1624.

NOV 24 1976

Date	Material	Amount	Total	Date	Amount
12-31-73	38' - 3/4" Copper			12-22-73	Deposit
12-20-73	Labor	18.32		11-24-75	Refund
	10% O.H.	1.83	\$20.15		
	35' 3/4" Copper Pipe	@1.05	36.75		
	1 3/4" Corporation		9.57		
	1 3/4" Curb Cock		11.32		
	1 Box & Rod		12.95		
	1 Hr. Trucking		3.00		
			\$93.74		


12.5 00
~~31.54~~
 93.74

DATE _____

TOWN OF LEXINGTON — BOARD OF PUBLIC WORKS

WATER DIVISION

Sketch of Service Here

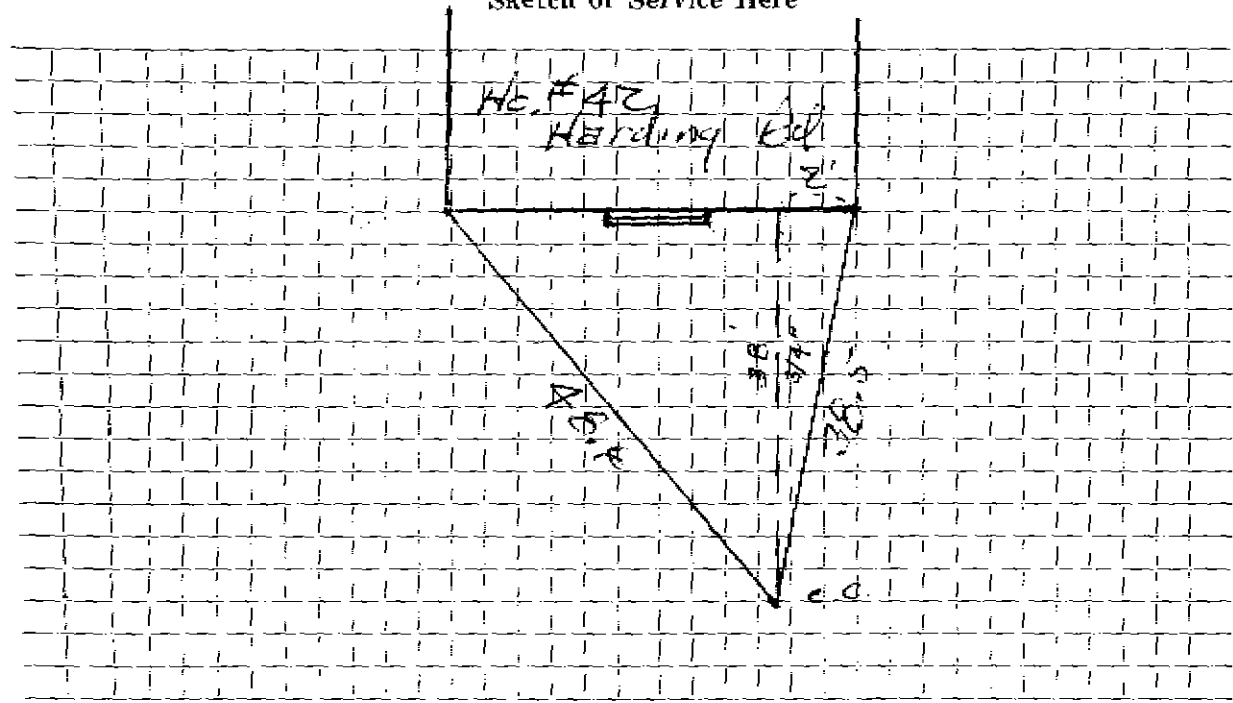

Connection made in Street. Work completed

Remarks:
.....
.....