

WATER SERVICE RECORD

Name R. D. Hamilton Const. Co.

Service No. 137

Address 43 Harding Road

Location Kirkland & Shaw

Repair—Renewal—New Service W.O. #9343 Permit #157

MAY 17 1965


Date	Material	Amount	Total	Date	Amount
11-23-64	Labor	4.62		11-10-64	50.00
	10% O.P.	.46	5.08	5-17-65	21.25
5'	3/4" Copper tubing @.42		2.10		28.25
1	3/4" Corp Cock		7.41		
1	3/4" Curb Cock		8.76		
1	Box & Rod		4.90		
			28.25		
4-15-65	43' 3/4" Copper tubing				

DATE _____

TOWN OF LEXINGTON — BOARD OF PUBLIC WORKS

WATER DIVISION

Sketch of Service Here

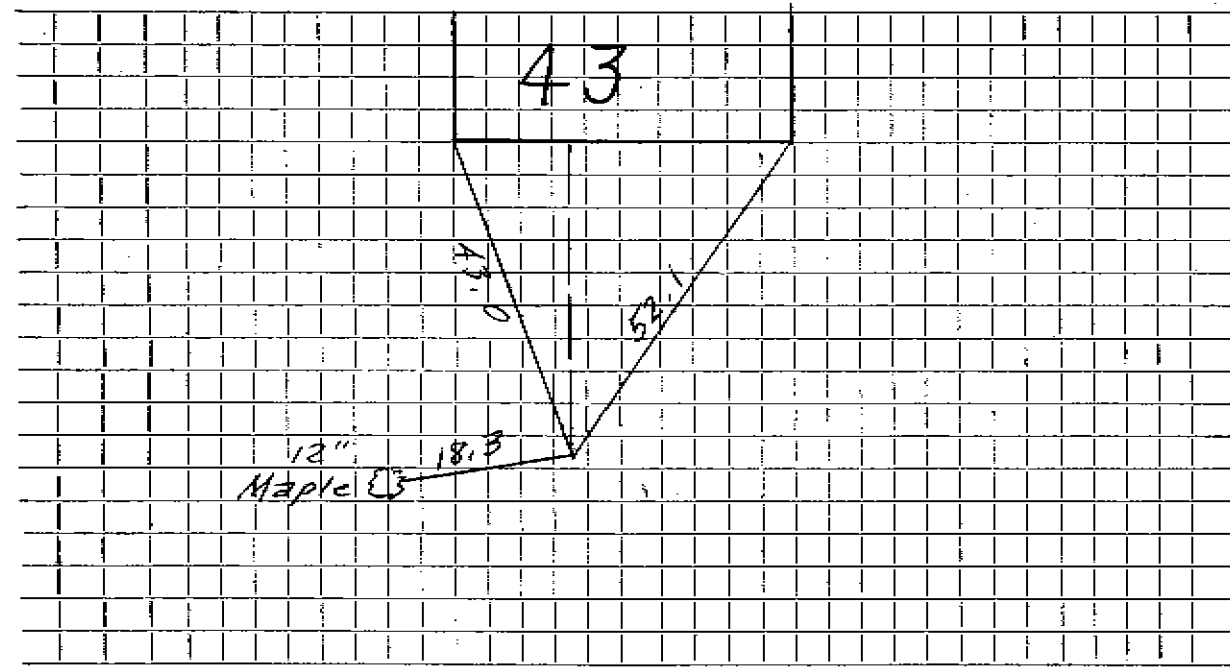

Connection made in Street. Work completed

Remarks:
.....
.....