

Name

Address

45 Harding Road

Service No. 1199

6687

Location

45 Harding Rd.

Kind of Pipe

Size

Size of Main

Repair—Renewal—New Service

Location

Date

Material

Amount

Total

Date

Amount

5-27-90

Outside
8' - 3/4 Copper
1 - Cop - Iron Adp.
1 3/4 Comp. Curb

Labor

DATE _____

TOWN OF LEXINGTON—BOARD OF PUBLIC WORKS

WATER DIVISION

The undersigned applies for a supply of water at No. _____ St. and hereby agrees to comply with the rules and regulations as now, or at any future time, established by the Board of Selectmen.

Am't. of Estimate \$ _____

Owner

J. Van Steenburgh


Am't. Paid \$ _____

Address

45 Harding Rd.

Builder _____

Sketch of Service Here

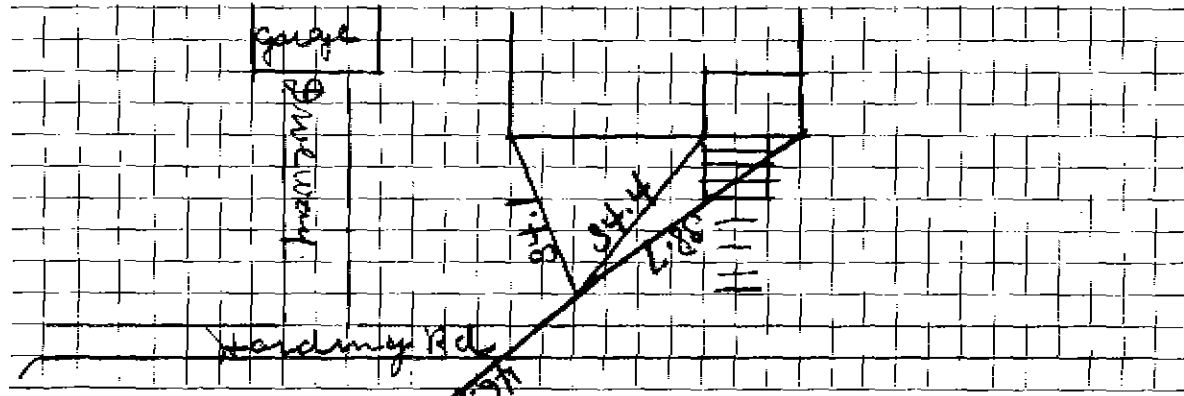

Connection made in _____ Street.

Work completed _____ 19

Remarks:

pre \$ 9.77