

Name Carl Andresen

Service No. 26 1200

Address 46 Harding Road

Lexington, Mass.

Location 46 Harding Road

Kind of Pipe

Size

Size of Main

~~Repair—Renewal—New Service~~

Location

Date	Material	Amount	Total	Date	Amount
Dec. 13, '44	Labor	5 30			
Dec. 13, '44	"	15.20	20 50		
	10% Overhead		2 05		
	321 $\frac{3}{4}$ " Copper Tubing		6 12		
	1 $\frac{3}{4}$ " C x $\frac{3}{4}$ " I.W.H. Stop & Waste		2 35		
	2 - 1" x $\frac{3}{4}$ " Red. Busings	3.33	66		
	Comp. 1 hr. @ .175		1 75		
	Trucking 1 hr. @ .75		75		
			<u>34 18</u>		
	Labor				

*No deposit*

Indley Press, Inc., Lexington

DATE \_\_\_\_\_

# TOWN OF LEXINGTON—BOARD OF PUBLIC WORKS

## WATER DIVISION

The undersigned applies for a supply of water at No. \_\_\_\_\_ St. and hereby agrees to comply with the rules and regulations as now, or at any future time, established by the Board of Selectmen.


Am't. of Estimate \$ \_\_\_\_\_

Owner \_\_\_\_\_

Am't. Paid \$ \_\_\_\_\_

Address \_\_\_\_\_

Builder \_\_\_\_\_

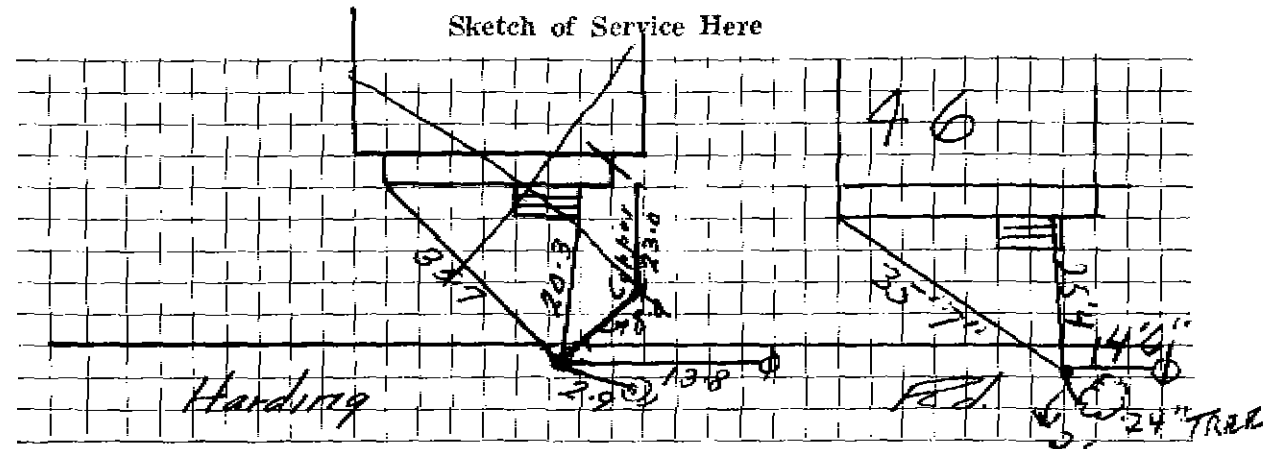

Connection made in \_\_\_\_\_ Street.

Work completed \_\_\_\_\_ 19\_\_

Remarks: