

Name Henry Tremblay
 Address 52 Harding Road
 Lexington, Mass.

Service No. 193

Location 52 Harding Road

443

Kind of Pipe

Size

Size of Main

~~Repair - Renewal~~ - New Service

Com. 11-6-50

Location

Date	Material	Amount	Total	Date	Material	Amount
Sept. 1, '50	Labor	1 50	1 50	July 28, '50	Reinstated	21 00
	10% Overhead		15			
	39' - 3/4" Copper Tubing	8.275	10 73		No Charge	16 50
	1 - 3/4" C x 1" I.W.R. 3/4"		3 29	Sept. 1, '50	Labor	1 50
	Trucking 1 hr. 0.75		75		26' - 3/4" Copper Tubing	8.275
			16 12		1 - 3/4" C wrg-cock	3 15
					1 - 3/4" C x 3/4" C Sub-cock	3 85
					1 - Cox & Rod	3 35
					1 - 1/2" Offset Tail Piece	42
					1 - 1/2" Straight Tail Piece	42
					Trucking 1 hr. 0.75	75
						20 59
	Labor					

Hadley Press, Inc., Lexington

DATE _____

TOWN OF LEXINGTON—BOARD OF PUBLIC WORKS

WATER DIVISION

The undersigned applies for a supply of water at No. _____ St. and hereby agrees to comply with the rules and regulations as now, or at any future time, established by the Board of Selectmen.

Am't. of Estimate \$ _____


Owner _____

Am't. Paid \$ _____

Address _____

Builder _____

Sketch of Service Here

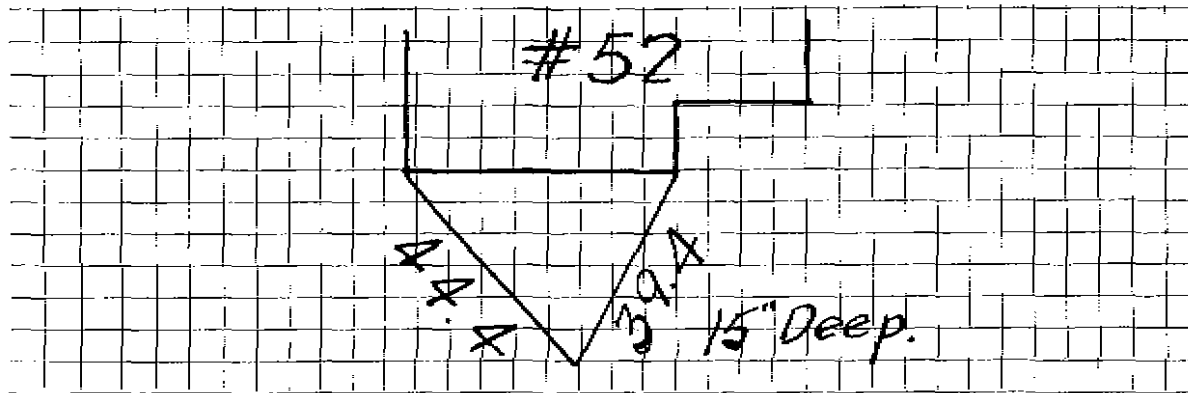

Connection made in _____ Street. Work completed _____ 19

Remarks: