


DATE 10/23/02

TOWN OF LEXINGTON — BOARD OF PUBLIC WORKS
WATER DIVISION

Sketch of Service Here
53 Harding

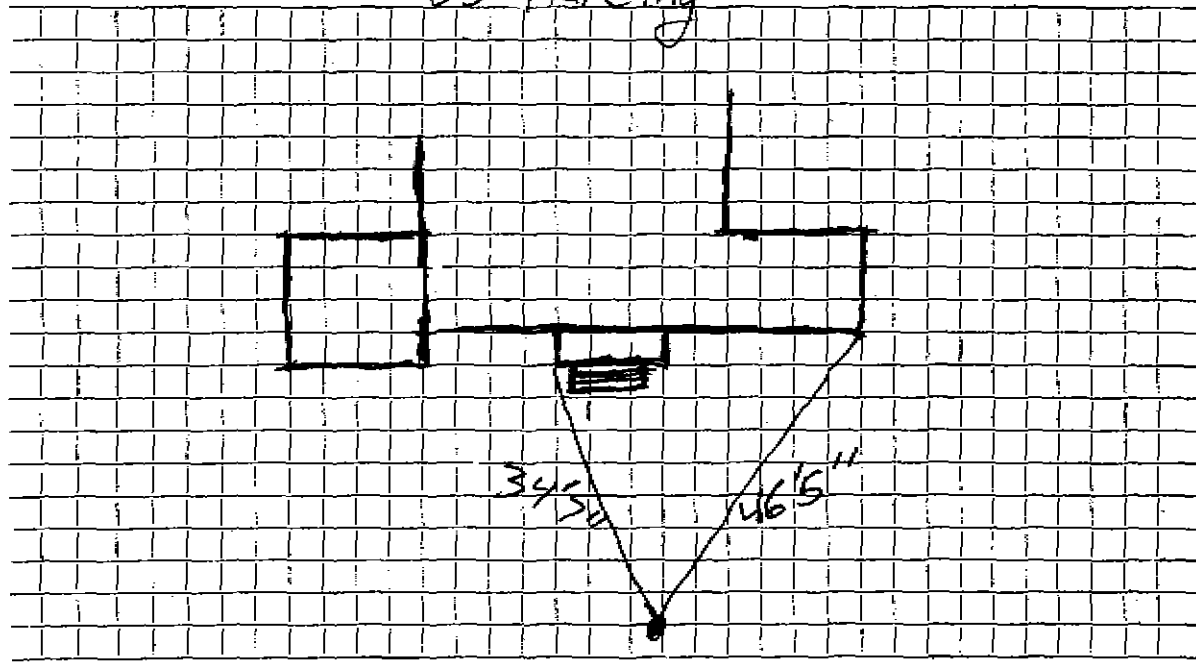

Connection made in Street. Work completed

Remarks:
.....
.....