

WATER SERVICE RECORD

Name Joseph J. Connors

Service No. 2

Address 54 Harding Rd.

Location

~~Repair~~—Renewal—~~New Service~~


JUN 20 1977

Date	Material	Amount	Total	Date	Amount
3/30/77	labor	66.84		3/11/77	Deposit 200.00
3/31/77	labor	45.12	111.96	6/24/77	Refund 19.89
	10%OH	11.19	123.15		180.11
25'	5/8 copper @ .88		22.00		
14'	3/4 copper @ .65		9.10		
1	1/2" valve		5.70		
1	1/2" male adapter		.42		
1	1/2" X 3/4" cuppling		.60		
1	yd. loam		4.25		
1	lb. seed		.39		
1/2	hr. trucking @3.00		1.50		
2	hrs. town shovel @ 6.50		13.00		
			180.11		

DATE \_\_\_\_\_

**TOWN OF LEXINGTON — BOARD OF PUBLIC WORKS**  
**WATER DIVISION**

Sketch of Service Here

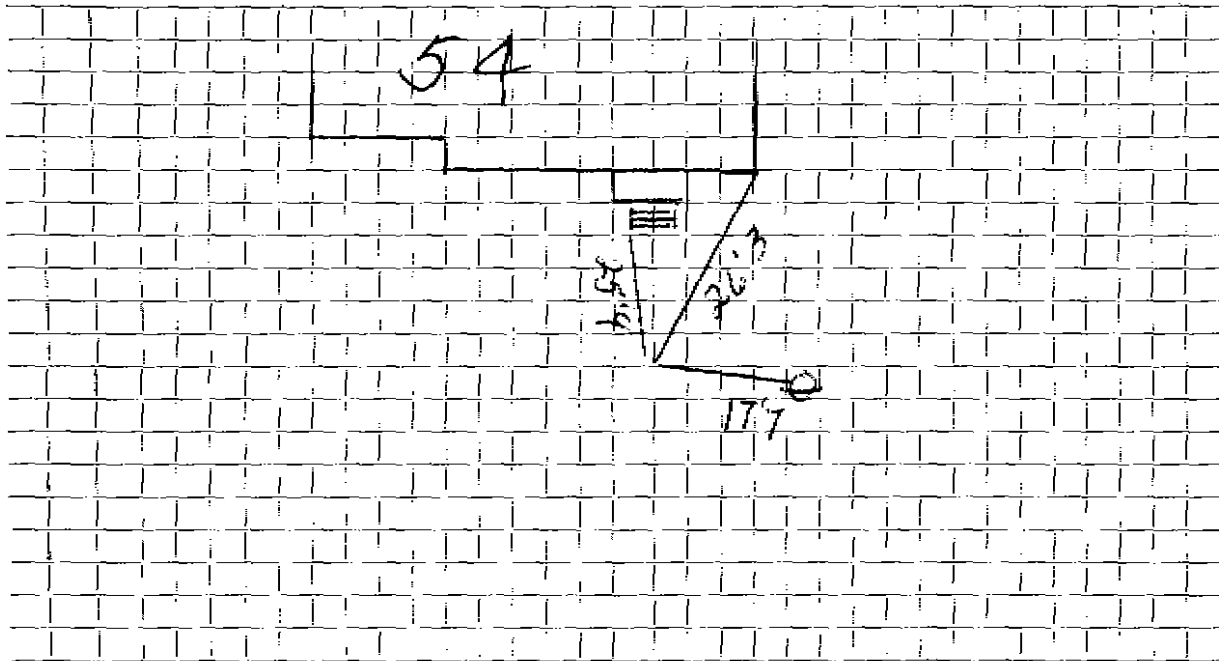

Connection made in ..... Street. Work completed .....

Remarks: .....

.....

.....