

Name George Walker

Service No. ~~SE~~ 1206

Address 231 Bedford St., Lexington, Mass.

42407
6924

55 Harding Road

Location 55 Harding Road

Kind of Pipe Size Size of Main

~~Repairs-Renewal~~ - New Service Location

Date 1938	Material	Amount	Total	Date	Amount
9/19/38	2 hrs @ 60¢	1 20	1 20	Sept. 19, 1938	28 50
<i>Oct 11-21-38</i>	41' 3/4" C. Tubing @ 20¢		8 20	<i>Dec 1938</i>	
	1 3/4" C.x I. W.H. S. & W.		3 75		
	2 hrs. Trucking @ 75¢		- 1 50		
			\$14 35		
	Flat Rate:				
	41' @ 50¢	20 50			
	Trench Repairs	8 00			
		\$28 50			
	Labor				

Hadley Press, Inc., Lexington

DATE Sept 16 1938

TOWN OF LEXINGTON—BOARD OF PUBLIC WORKS

WATER DIVISION

The undersigned applies for a supply of water at No. 55 Harding Rd. St. and hereby agrees to comply with the rules and regulations as now, or at any future time, established by the Board of Selectmen.

Am't. of Estimate \$ _____


Owner George Walker

Am't. Paid \$ _____

Address 231 Bedford St
Lexington

Builder P. J. Jones

Sketch of Service Here

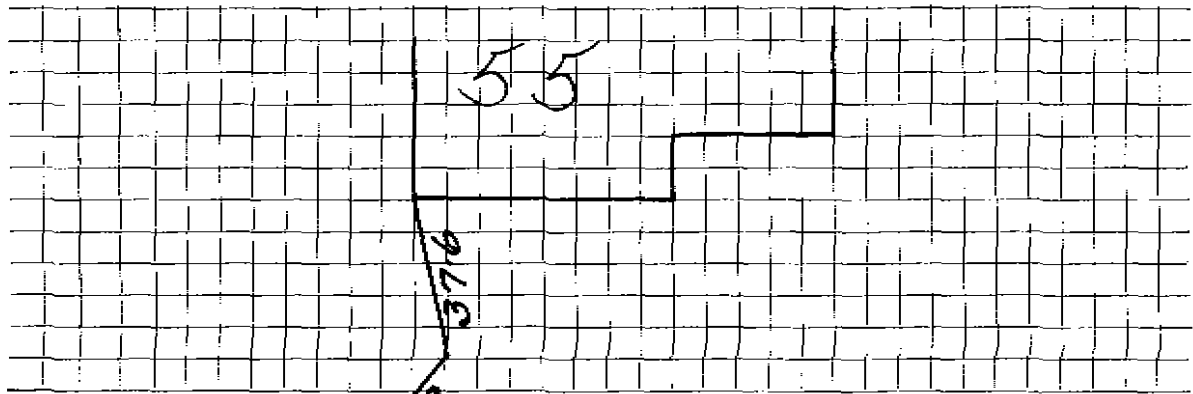

Connection made in _____ Street. Work completed _____ 19

Remarks: