

Name Ruth J. Rideout

1411 1410

Service No. 54 3153

Address 7 Sherman Court
#56 Harding Rd.
Weburn, Mass.

Location 56 Harding Road

Kind of Pipe

Size

Size of Main

~~Repair-Renewal~~ New Service

Com 9-23-46

Location

Date	Material	Amount	Total	Date	Location	Amount
July 10, '46	Labor	8 62		July 5, '46	Suposited	50 00
July 11, '46	"	<u>10 10</u>	18 72	Nov. 12, '46	Band	<u>6 00</u>
	10% Overhead		1 87		Non-Charge	56 00
	41' - 3/4" Copper Tubing @ .1211		7 84	July 11, '46	Labor	27 46
	1 - 3/4" C x 1/2" I.W.H. Stop & waste		2 82	30' - 3/4" Copper Tubing @ .1911		5 73
	Patching 24' x 3'		22 00	1 - 3/4" C Corp-cock		2 70
	Trucking 1 hr. @ .75		<u>75</u>	1 - 3/4" C x 3/4" C. Curb-cock		3 30
			56 00	1 - Box & Rod		1 65
				1 - 1/2" Offset Tail Piece		90
				1 - 1/2" Straight Tail Piece		90
				Trucking 1 hr. @ .75		<u>75</u>
	Labor					43 39

Hadley Press, Inc., Lexington

DATE _____

TOWN OF LEXINGTON—BOARD OF PUBLIC WORKS

WATER DIVISION

The undersigned applies for a supply of water at No. _____ St. and hereby agrees to comply with the rules and regulations as now, or at any future time, established by the Board of Selectmen.


Am't. of Estimate \$ _____

Owner _____

Am't. Paid \$ _____

Address _____

Builder _____

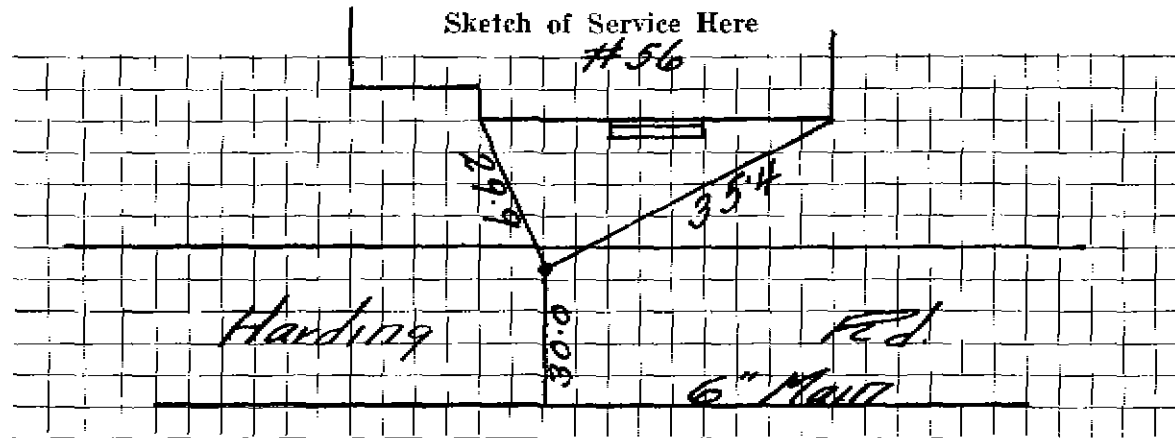

Connection made in _____ Street. Work completed _____ 19

Remarks: