

Name. J. Everett Ready
 Address 1782 Mass. Avenue
 57 Harding Rd.

Service No. ~~00~~ 1207
 #7424
 # 227

Location 57 Harding Road

Kind of Pipe

Size

Size of Main

Repair—Renewal—New Service

Location

Date
1939

Material

Amount

Total

Date

Amount

12/30/39

8 hrs. @ 50¢ 4 00

December 27, 1939 Deposited

25 00

Corr 1-22-40

6 " @ 60¢ 3 60

January 31, 1940 Paid

2 59

1 " @ 65¢ 65

8 25

27 59

41' 3/4" Copper tubing @ 19¢

7 79

1 3/4" C.x¹/₂" I.S.& W.

2 10

2 hrs. trucking @ 75¢

1 50

Trench repairs

7 12

26 76

10% Overhead on labor

8 3

27 59

Labor

DATE Dec 22, 1929.

TOWN OF LEXINGTON—BOARD OF PUBLIC WORKS

WATER DIVISION

The undersigned applies for a supply of water at No. 57 Harding Rd. St. and hereby agrees to comply with the rules and regulations as now, or at any future time, established by the Board of Selectmen.

Am't. of Estimate \$ 25

Owner


Am't. Paid \$ _____

Address

Builder _____

John E. Keedy
1782 Mass. Ave.
Lexington Mass.

Sketch of Service Here

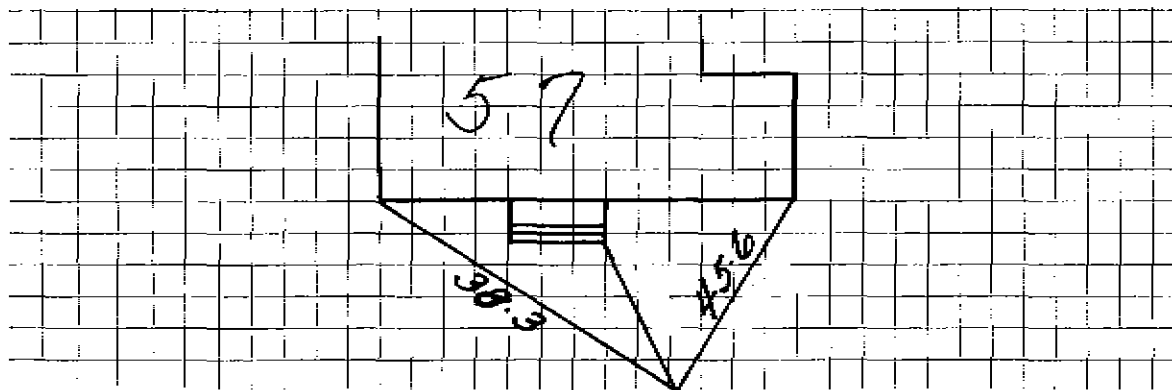

Connection made in _____ Street.

Work completed _____ 19

Remarks: