


DATE _____

TOWN OF LEXINGTON — BOARD OF PUBLIC WORKS

WATER DIVISION

Sketch of Service Here

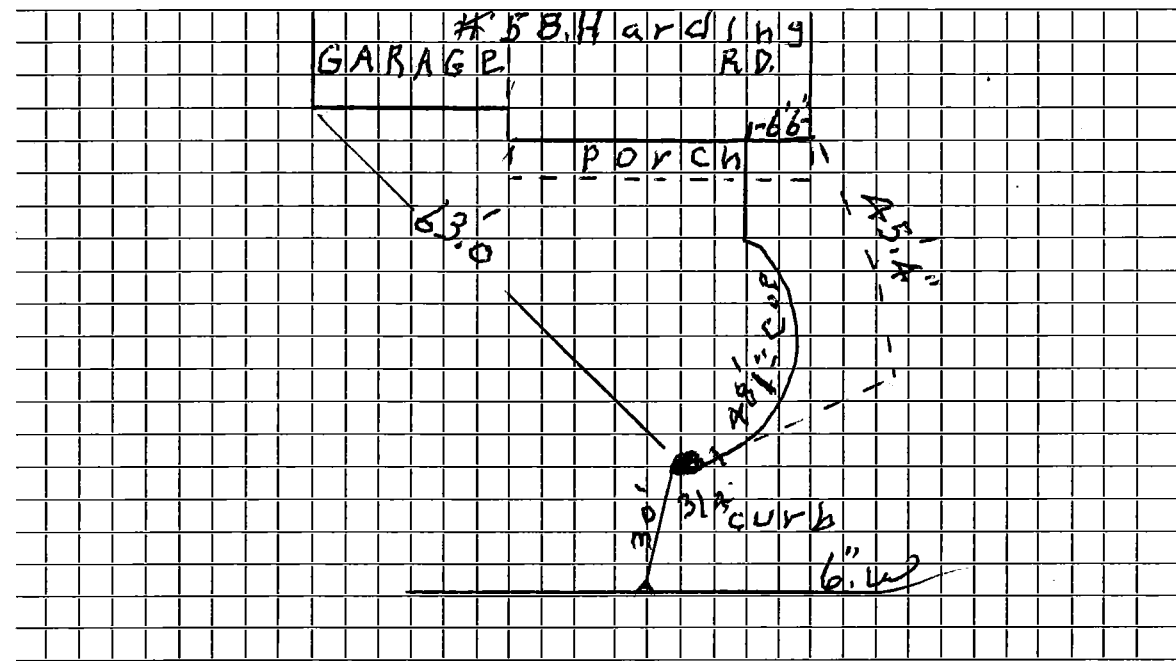

Connection made in Street.

Work completed 9/26/2015 J. McLaughlin

Remarks: Water line bumped out to right of drainage system

.....
.....