




DATE 7/2018

TOWN OF LEXINGTON — BOARD OF PUBLIC WORKS  
WATER DIVISION

Sketch of Service Here

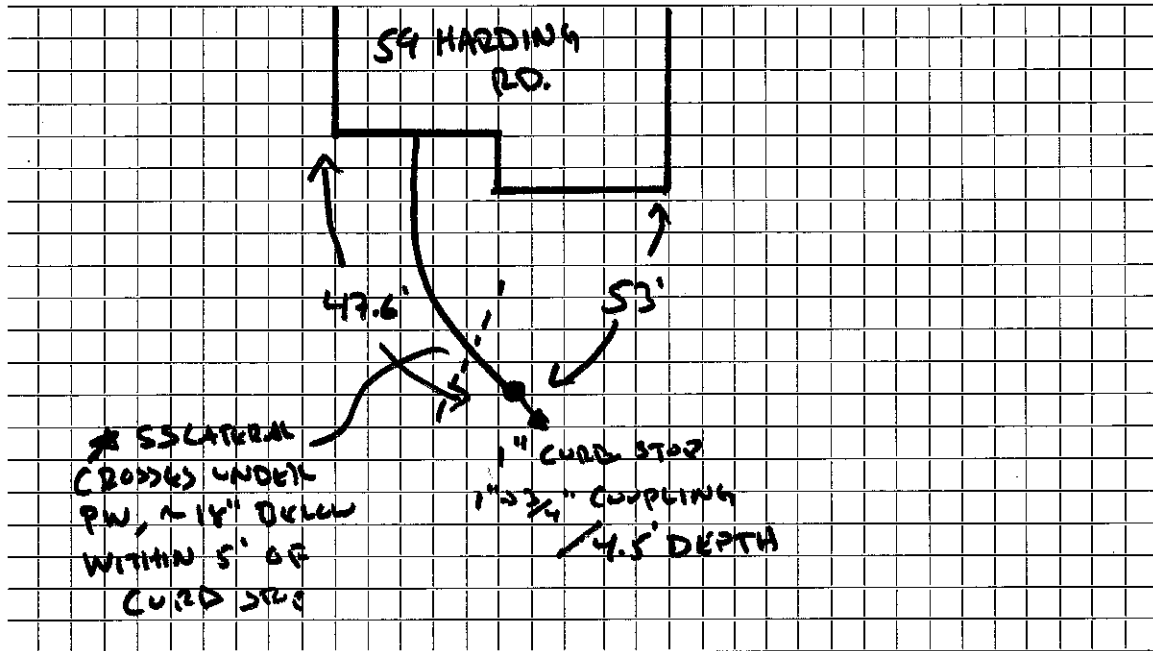

Connection made in HARDING Street. Work completed EYCON DEVELOPMENT

Remarks: .....

.....

.....