

WATER SERVICE RECORD

Name *Ingeborg McDougall*

Service No.

Address *60 Harding Road*

Location


Repair—~~Renewal~~ ~~New Service~~ *Valeri #4470*

Date	Material	Amount	Total	Date	Amount
7/16/84	65' 3/4" Copper Tubing				
	3/4" x 3/4" Wheel Valve				
					OUTSIDE W.O. #893
				7/16/84 27½'	3/4" Cppper Tubing
					Patch - 32' x 8'

DATE \_\_\_\_\_

TOWN OF LEXINGTON — BOARD OF PUBLIC WORKS  
WATER DIVISION

Sketch of Service Here

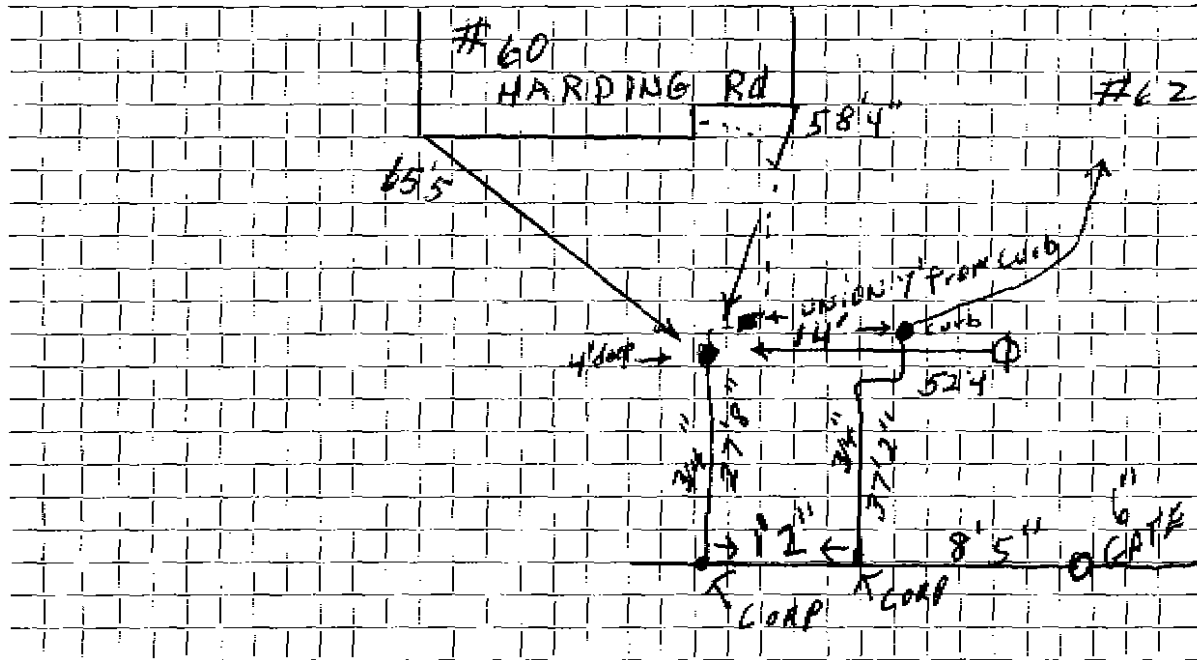

Connection made in ..... Street. Work completed .....

Remarks: .....

.....

.....