

WATER SERVICE RECORD

Name Fred J. Dutille

Service No. 195

Address 61 Harding Road

Location Lexington

~~Repair~~ ~~Renewal~~ — New Service

Can. 11-3-52


Date	Material	Amount	Total	Date	Amount	
9/16/52	Labor	1 63		9-3-52	25 00	
	10% Overhead	16	1 79	11-5-52	1 46	
	50' - 3/4" Copper tubing @ .34	17 00			23 51	
	1 - 3/4" C x 1/2 I.W.H. stop & waste	4 00				
	1 hr. trucking		75	9/16/52	Labor	1 63
			23 54		10' - 3/4" Copper tubing @ .34	3 40
					1 - 3/4" C. Corp-cock	4 33
					1 - 3/4" C. curb-cock	4 67
					1 box and rod	3 90
					1 - 1/2 straight tail piece	50
					1 - 1/2 offset tail piece	50
					1 hr. trucking	75
						19 68

DATE _____

TOWN OF LEXINGTON — BOARD OF PUBLIC WORKS

WATER DIVISION

Sketch of Service Here

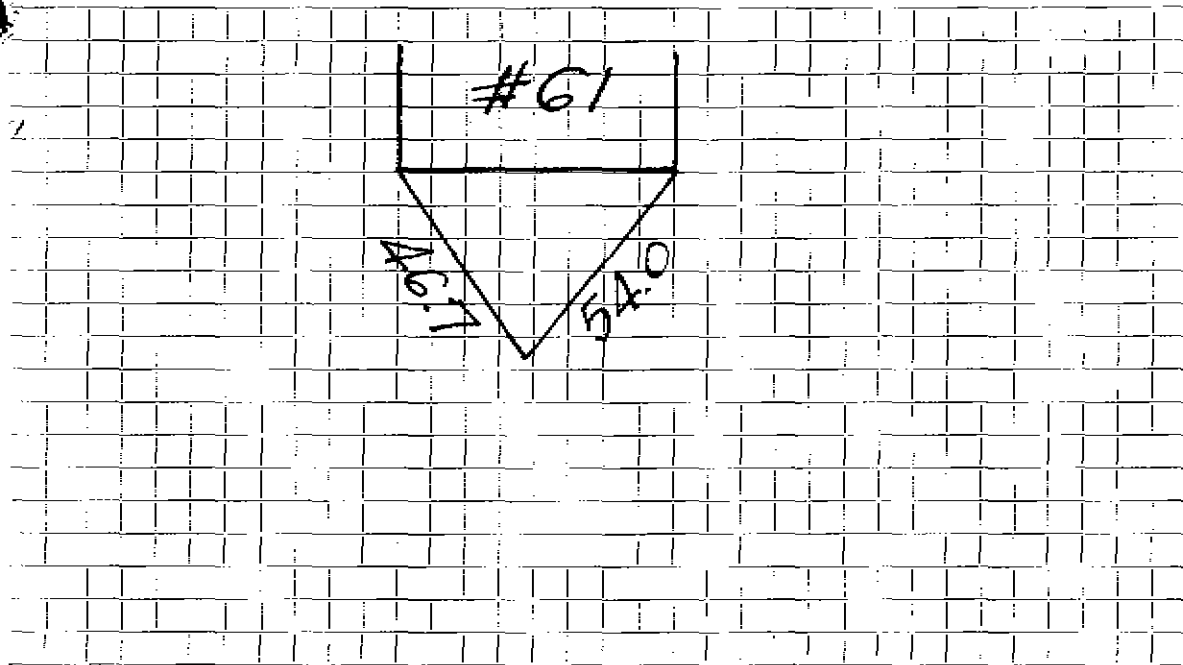

Connection made in Street. Work completed

Remarks:

.....

.....