


Water Service Tie Card
TOWN OF LEXINGTON
 MASSACHUSETTS

63 Harding Rd

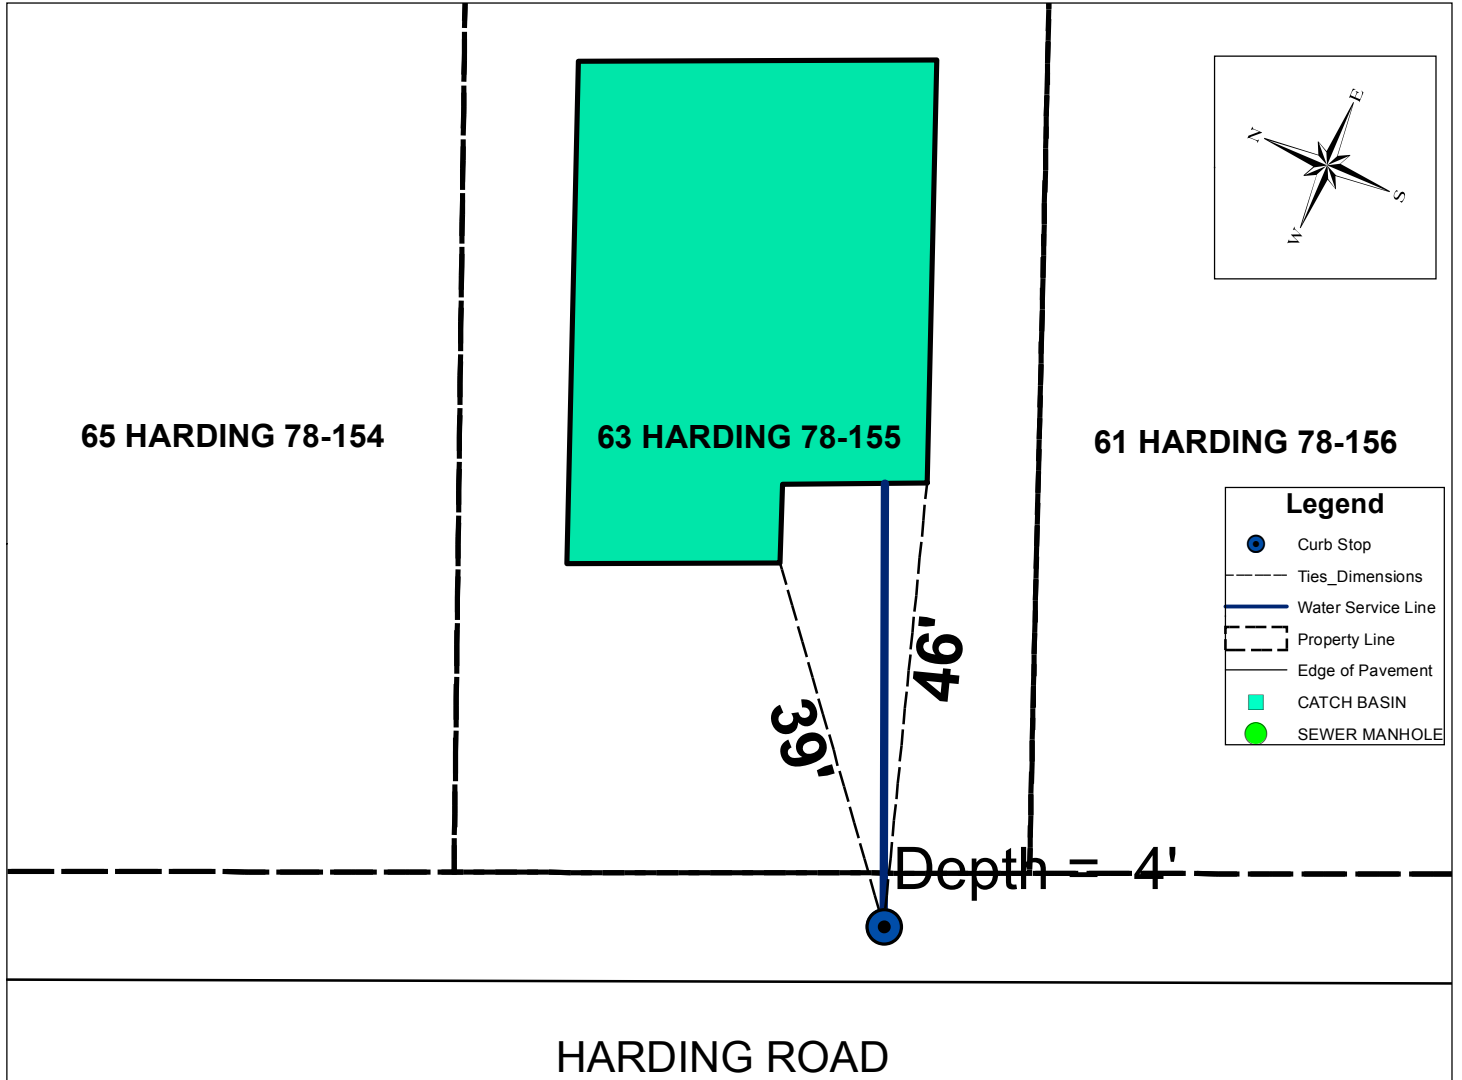

Address	Map and Lot	Permit Number	Contractor Name	Inspector
63 Harding Rd	78-155	6027	McLaughlin, James M. Inc.	msprague
Date	Material	Depth of Cover	Amount	
12/5/2014	1" Curb Valve and Buffalo Box	4 ft	1	
	1" Copper type "k"	4.0 ft	42 ft to HSE	
Type of work completed				

New 1" water service to house from curb stop. New house on lot old house removed.