


DATE 11-07-02

TOWN OF LEXINGTON — BOARD OF PUBLIC WORKS
WATER DIVISION

Sketch of Service Here

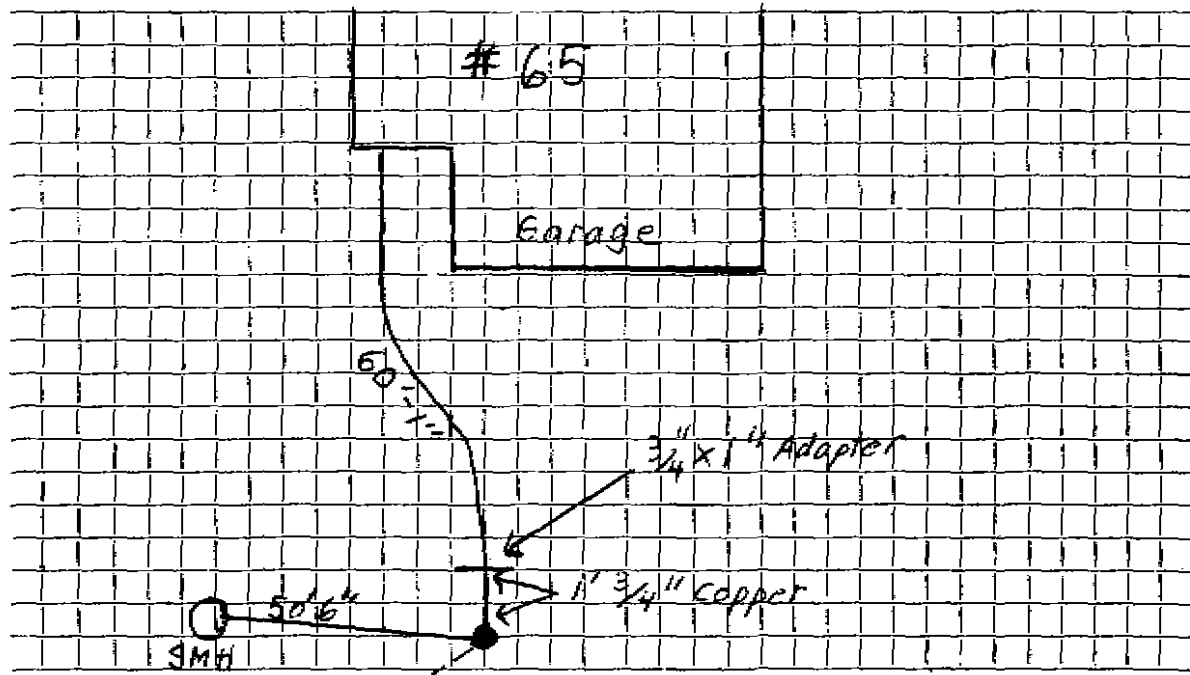

Connection made in Pole 13 Street. Work completed

Remarks: