

Name Seb Homes, Inc.  
 Address 66 Harding Road  
 Lexington, Mass.

1384

Service No. 229

Locatic 66 Harding Road

Kind of Pipe

Size

Size of Main

~~Repair-Renewal~~ - New Service

Com. 11-6-50

Location

Date	Material	Amount	Total	Date	Amount
Aug. 29, '50	Labor	1 50	1 50	Aug 10 '50	20 00
	10% Overhead		15		1 50
	29' - 3/4" Copper Tubing	2.275	7 93		10 00
	1 - 3/4" x 1/2" W.H. S&W		3 29	Aug. 29, '50	2 50
	Trucking 1 hr.	0.75	75	30' - 3/4" Copper Tubing	6 25
			13 67	1 - 2/4" Corp-cock	3 15
				1 - 3/4" x 3/4" Corp-cock	3 85
				1 - Box & Rod	3 35
				1 - 3" Offset Tail Piece	1 42
				1 - 3" Straight Tail Piece	1 42
				Trucking 1 hr.	0.75
					22 60
	Labor				

Hudley Ives, Inc., Lexington

DATE \_\_\_\_\_

# TOWN OF LEXINGTON—BOARD OF PUBLIC WORKS

## WATER DIVISION

The undersigned applies for a supply of water at No. \_\_\_\_\_ St. and hereby agrees to comply with the rules and regulations as now, or at any future time, established by the Board of Selectmen.

Am't. of Estimate \$ \_\_\_\_\_


Owner \_\_\_\_\_

Am't. Paid \$ \_\_\_\_\_

Address \_\_\_\_\_

Builder \_\_\_\_\_

Sketch of Service Here

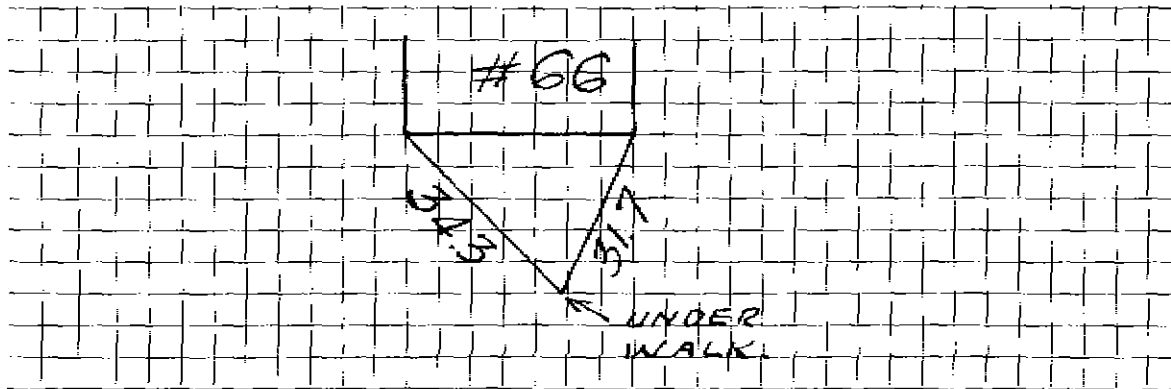

Connection made in \_\_\_\_\_ Street.

Work completed \_\_\_\_\_ 19

Remarks: