

Name Charles S. Purinton

Service No. 142

Address ~~67~~ Harding Road

Lexington, Mass.

Locatic

67

~~67~~ Harding Road

#5368

Kind of Pipe

Size

Size of Main

~~Repair - Renewal~~ New Service

Com. 9-5-50

Location

Date

Material

Amount

Total

Date

Amount

Jul. 14, '50

Labor 1 30
 10% Overhead 13
 12' - 3/4" Copper Tubing @.23 2 76
 1 - 3/4" C x 3/8" I.W.H. S&W 3 29
 1 - 3/4" C x 3/4" C Union (3pts) 1 39
 Trucking 1 hr. @.75 75

1 30
 13
 2 76
 3 29
 1 39
 75
 9 62

June 28 '50 Deposited

No Charge

Jul. 14, '50 Labor
 12' - 3/4" Copper Tubing @.23
 1 - 3/4" C Corp-cock
 1 - 3/4" C x 3/4" C Curb-cock
 1 - Box & Rod
 1 - 1" Offset Tail Piece
 1 - 1" Straight Tail Piece
 Trucking 1 hr. @.75

15 00
 9 62
 1 30
 2 76
 3 15
 3 85
 3 35
 38
 38
 75
 15 92

Labor

DATE _____

TOWN OF LEXINGTON—BOARD OF PUBLIC WORKS

WATER DIVISION

The undersigned applies for a supply of water at No. _____ St. and hereby agrees to comply with the rules and regulations as now, or at any future time, established by the Board of Selectmen.

Am't. of Estimate \$ _____


Owner _____

Am't. Paid \$ _____

Address _____

Builder _____

Sketch of Service Here

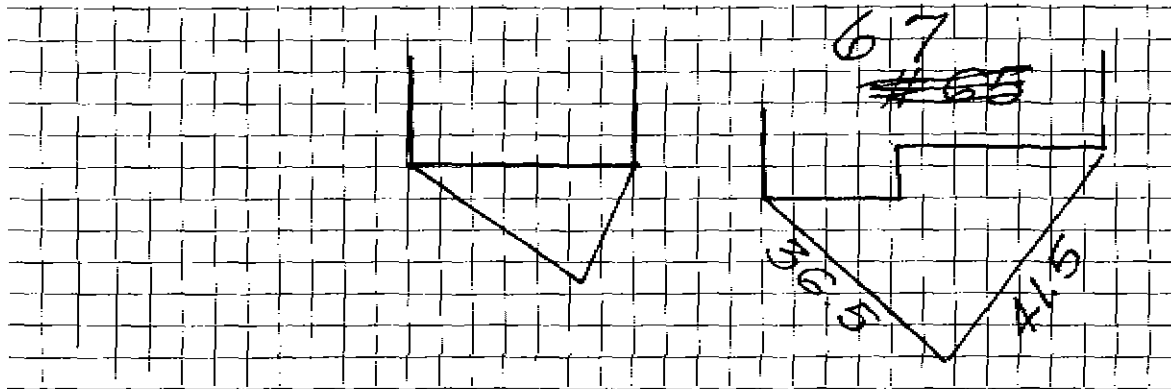

Connection made in _____ Street.

Work completed _____ 19

Remarks: