

WATER SERVICE RECORD

Name John Puopolo

Service No. 112

Address 68 Harding Road

Location Lexington, Mass.

Requires Removal—New Service

#2646


#6961

Date	Material	Amount	Total	Date		Amount
7-18-51	Labor	1 49	1 49	7-18-51	Deposited	20 00
	10% Overhead		15	7-19-51	Paid	2 28
	45' -3/4" Copper Tubing @ .326	14 67				22 78
	1-3/4" Cx 1/2 I.W.H. S&W	4 00			No Charge	
	1-3/4" Cx 3/4" C Union (3pts)	1 72	7-18-51	Labor		1 49
		75	30' -3/4" Copper Tubing @ .326			9 78
		22 78	1-3/4" C Corp-Cock			4 33
			1-3/4" Cx 3/4" C Curb-Cock			4 67
			1-Box & Rod			4 68
			1-1/8 Offset Tail Piece			50
			1-1/2 Straight Tail Piece			50
			1 Hr Trucking			75
						26 70

DATE _____

TOWN OF LEXINGTON — BOARD OF PUBLIC WORKS
WATER DIVISION

Sketch of Service Here

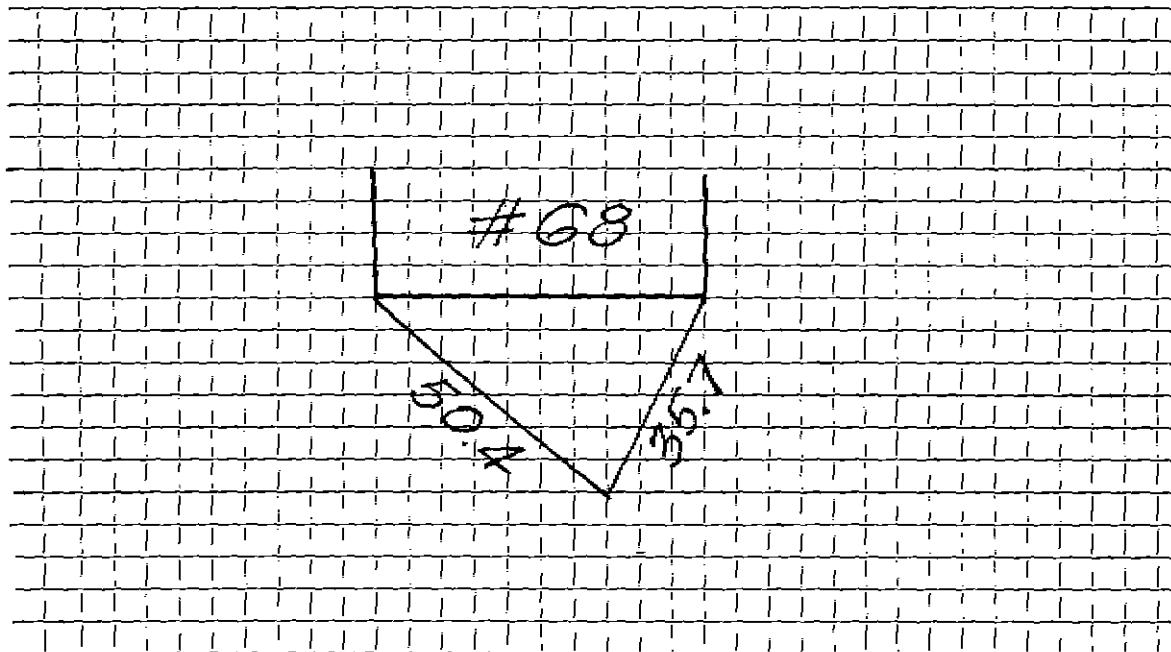

Connection made in Street. Work completed

Remarks: