

Name Deb Homes, Inc.

Service No. 280

202

Address 69 Harding Road

Lexington, Mass.

Locatio 69 Harding Road

Kind of Pipe

Size

Size of Main

~~Repair/Rehaul~~—New Service

Com. 11-6-50

Location

Date	Material	Amount	Total	Date	Amount
Aug. 31, '50	Labor	1 50	1 50	Aug 29 '50	2 00
	10% Overhead		15		1 50
	33' - 3/4" Copper Tubing @.275		9 08		14 75
	1 - 3/4" C x 1/2" I.W.H. S&W		3 29	Aug. 31, '50	1 50
	Trucking 1 hr. @.75		75	11' - 3/4" Copper Tubing @.275	3 03
			14 77	1 - 3/4" C Corp-cock	3 15
				1 - 3/4" C x 3/4" C Curb-cock	3 85
				1 - Box & Rod	3 35
				1 - 1/2" Offset Tail Piece	42
				1 - 1/2" Straight Tail Piece	42
				Trucking 1 hr. @.75	75
					16 47
	Labor				

Lindley Trees, Inc., Lexington

DATE \_\_\_\_\_

# TOWN OF LEXINGTON—BOARD OF PUBLIC WORKS

## WATER DIVISION

The undersigned applies for a supply of water at No. \_\_\_\_\_ St. and hereby agrees to comply with the rules and regulations as now, or at any future time, established by the Board of Selectmen.

Am't. of Estimate \$ \_\_\_\_\_


Owner \_\_\_\_\_

Am't. Paid \$ \_\_\_\_\_

Address \_\_\_\_\_

Builder \_\_\_\_\_

Sketch of Service Here

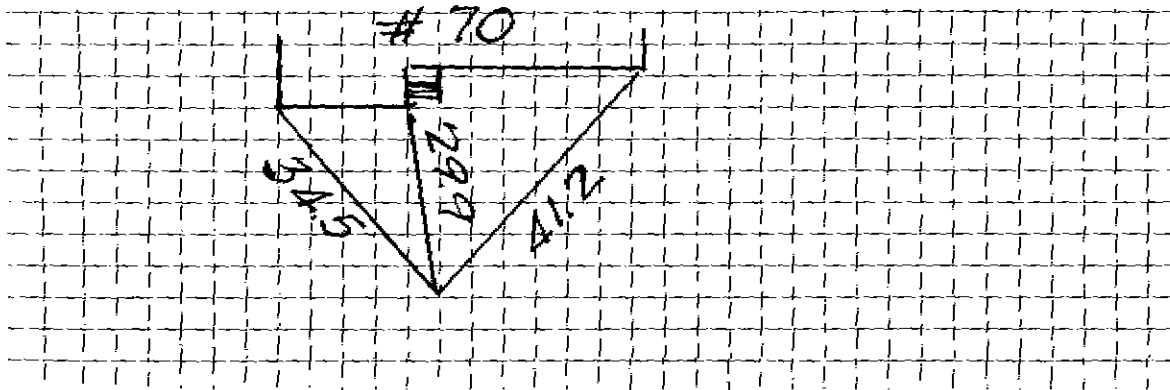

Connection made in \_\_\_\_\_ Street.

Work completed \_\_\_\_\_ 19

Remarks:

Name Deb Homes, Inc.  
 Address 69 Harding Road  
 Lexington, Mass.

Service No. 280

202

Location 69 Harding Road

Kind of Pipe

Size

Size of Main

~~REPAIRS~~—New Service

Com. 11-6-50

Location

Date	Material	Amount	Total	Date	Amount
Aug. 31, '50	Labor	1 50	1 50	Aug 29 '50	2 00
	10% Overhead		15		3 03
	33' - 3/4" Copper Tubing @.275		9 08		14 77
	1 - 3/4"C x 1/2" I.W.H. S&W		3 29		
	Trucking 1 hr. @.75		75		
			14 77		
				Aug. 31, '50	1 50
				11' - 3/4" Copper Tubing @.275	3 03
				1 - 3/4"C Corp-cock	3 15
				1 - 3/4"C x 3/4"C Curb-cock	3 85
				1 - Box & Rod	3 35
				1 - 1/2" Offset Tail Piece	42
				1 - 1/2" Straight Tail Piece	42
				Trucking 1 hr. @.75	75
					16 47
	Labor				

*Relocated*  
*No Charge*

Hadley Press, Inc., Lexington

DATE \_\_\_\_\_

# TOWN OF LEXINGTON—BOARD OF PUBLIC WORKS

## WATER DIVISION

The undersigned applies for a supply of water at No. \_\_\_\_\_ St. and hereby agrees to comply with the rules and regulations as now, or at any future time, established by the Board of Selectmen.

Am't. of Estimate \$ \_\_\_\_\_


Owner \_\_\_\_\_

Am't. Paid \$ \_\_\_\_\_

Address \_\_\_\_\_

Builder \_\_\_\_\_

Sketch of Service Here

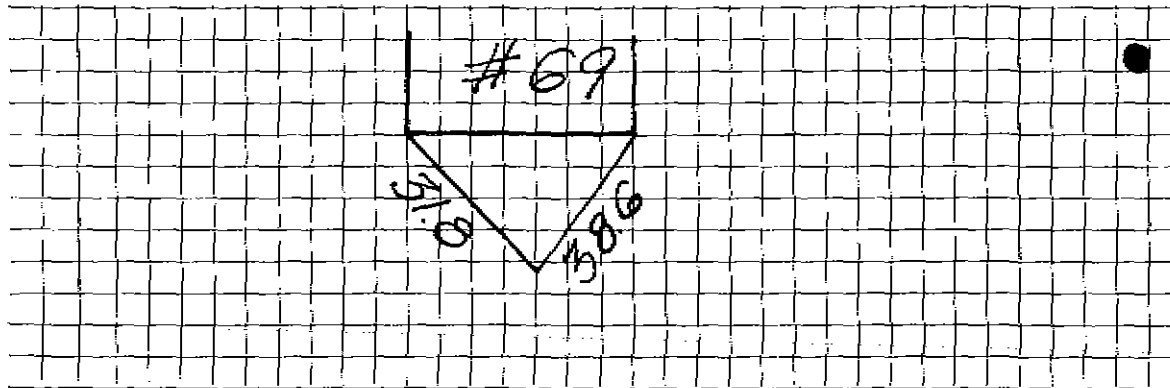

Connection made in \_\_\_\_\_ Street.

Work completed \_\_\_\_\_ 19

Remarks: