

Name Deb Homes, Inc.
 Address 70 Harding Road
 Lexington, Mass.

Service No. 229

Locatic 70 Harding Road

Kind of Pipe

Size

Size of Main

~~Repair - Renewal~~ - New Service

Com. 11-6-50

Location

Date	Material	Amount	Total	Date	Amount
Aug. 28 '50	Labor	1 50	1 50	Aug 15 '50	2 00
	10% Overhead		15		7 25
	37' - 3/4" Cooper Tubing	3.275	10 18		15 27
	1 - 3/4" C x 1/2" I.W.H. S&W		3 29	Aug. 28, '50	1 50
	Trucking 1 hr. @ .75		75	29' - 3/4" Cooper Tubing	7 98
			15 87	1 - 3/4" C Corp-cock	3 15
				1 - 3/4" C x 3/4" Curb-cock	3 85
				1 - Box & Rod	3 35
				1 - 1/2" Offset Tail Piece	42
				1 - 1/2" Straight Tail Piece	42
				Trucking 1 hr. @ .75	75
					21 42
	Labor				

Reported
11-7-50
 No Charge

Hadley Press, Inc., Lexington

DATE _____

TOWN OF LEXINGTON—BOARD OF PUBLIC WORKS

WATER DIVISION

The undersigned applies for a supply of water at No. _____ St. and hereby agrees to comply with the rules and regulations as now, or at any future time, established by the Board of Selectmen.

Am't. of Estimate \$ _____


Owner _____

Am't. Paid \$ _____

Address _____

Builder _____

Sketch of Service Here

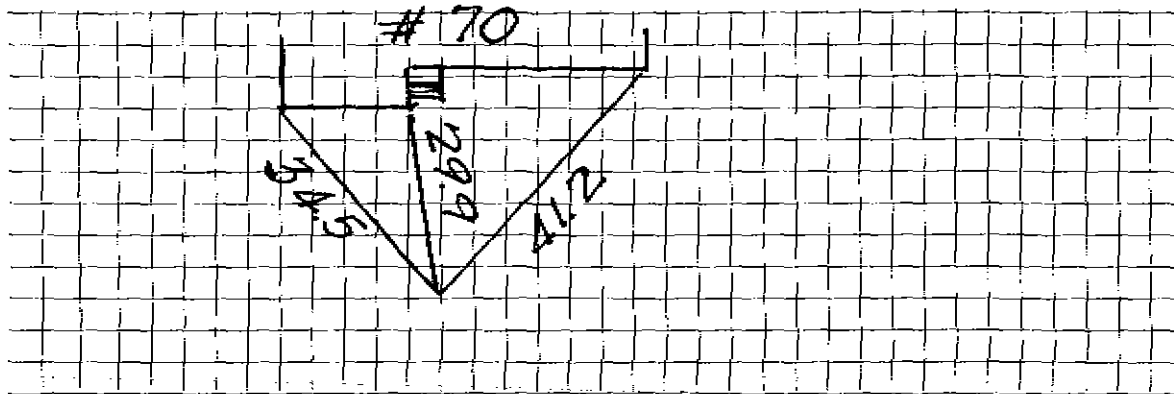

Connection made in _____ Street.

Work completed _____ 19

Remarks: