

WATER SERVICE RECORD

Name

Service No.

Address *78 Harding Road*

Location

Repair—Renewal—New Service


Date	Material	Amount	Total	Date	Amount
<i>9/15/50</i>	<i>Labor</i>	<i>3.50</i>			
	<i>10% O.H.</i>	<i>.36</i>	<i>3.96</i>		
<i>36'</i>	<i>3/4" Copper tubing</i>		<i>9.90</i>		
<i>1</i>	<i>3/4" C x 1/2" I.W.H. S & W</i>		<i>3.29</i>		<i>OUTSIDE</i>
<i>1</i>	<i>3/4" C x 3/4" C Union 3 pts.</i>		<i>1.39</i>	<i>7/24/86</i>	<i>150' 1" Copper</i>
<i>1</i>	<i>hr. Brox Shovel @ \$9.00</i>		<i>9.00</i>	<i>2</i>	<i>1" 3 part unions</i>
<i>1</i>	<i>hr. Trucking @.75</i>		<i>.75</i>	<i>1</i>	<i>1" Curb</i>
			<i>\$28.29</i>	<i>1</i>	<i>1" Corp</i>
				<i>1</i>	<i>Box & Rod</i>
				<i>1</i>	<i>1" x 3/4" 3 pt. union</i>

DATE _____

TOWN OF LEXINGTON — BOARD OF PUBLIC WORKS

WATER DIVISION

Sketch of Service Here

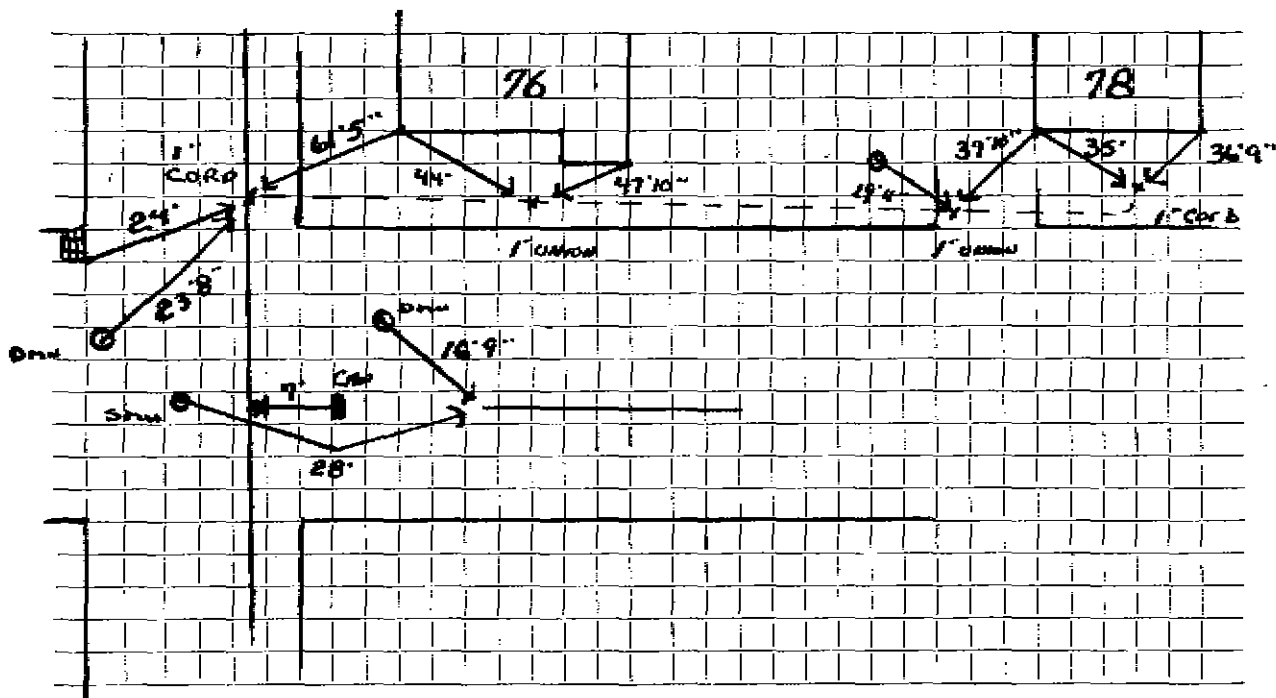

Connection made in Street. Work completed

Remarks:
.....
.....