




DATE \_\_\_\_\_

TOWN OF LEXINGTON — BOARD OF PUBLIC WORKS  
WATER DIVISION

Sketch of Service Here

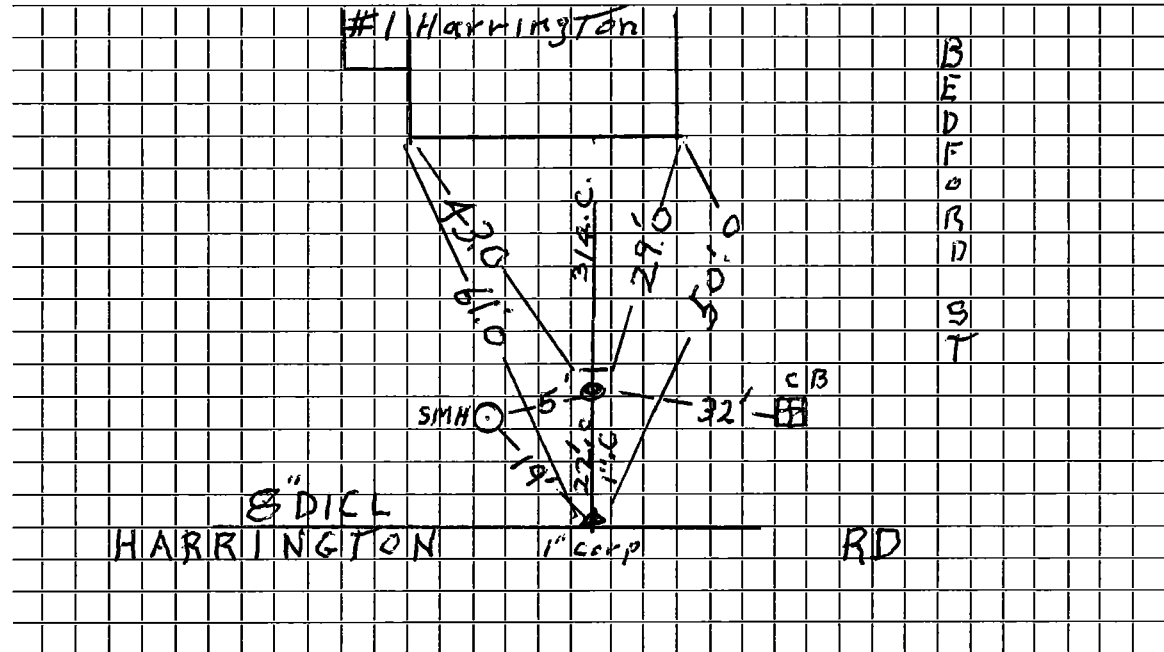

Connection made in Harrington B.D. Street. Work completed 2010 Grasse

Remarks:.....  
.....  
.....