


TOWN OF LEXINGTON — BOARD OF PUBLIC WORKS
WATER DIVISION

Sketch of Service Here

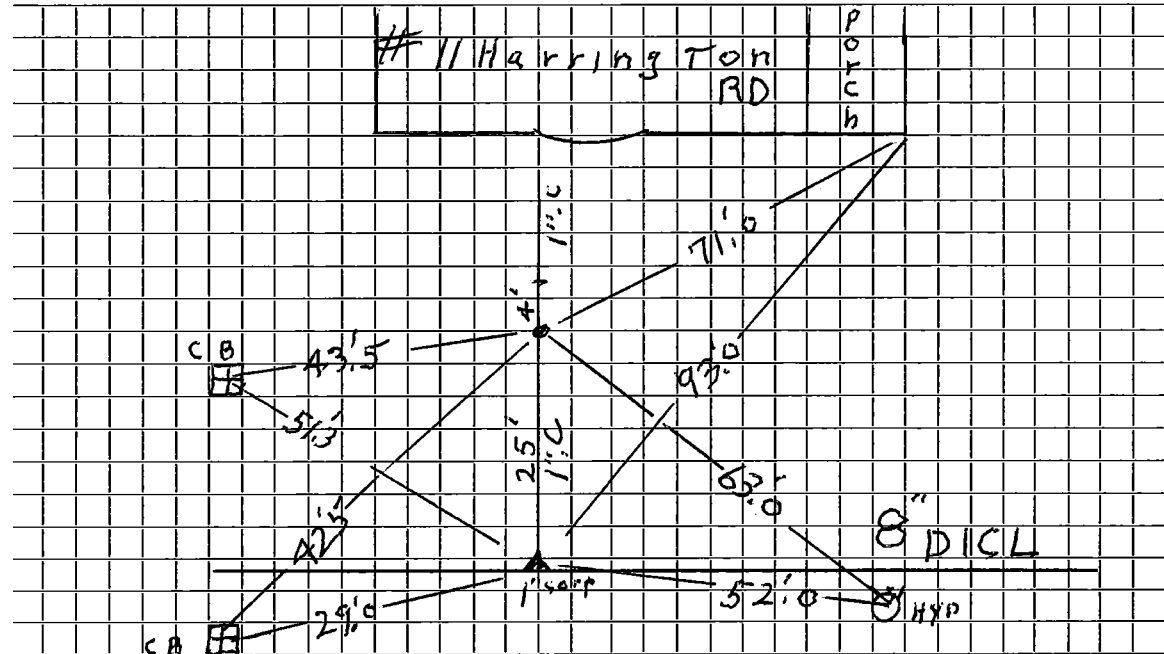

Connection made in Harrington RD Street.

Work completed 11/23/10 Gramese

Remarks:

.....

.....