


DATE _____

TOWN OF LEXINGTON — BOARD OF PUBLIC WORKS

WATER DIVISION

Sketch of Service Here

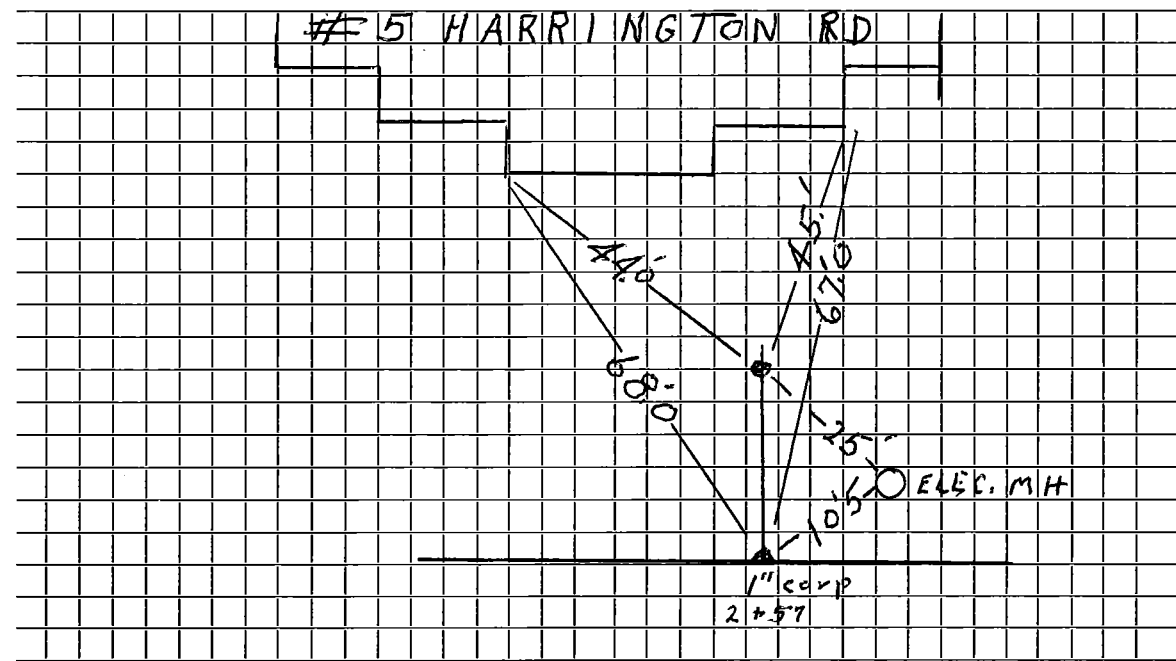

Connection made in Harrington Rd Street.

Work completed 11/22/10 Grantee

Remarks: New 8" W.M. D.I.C.L.

.....
.....