
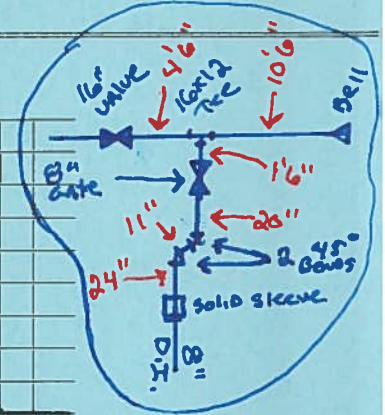


DATE 10/15/2019

TOWN OF LEXINGTON — BOARD OF PUBLIC WORKS

WATER DIVISION

113/115
Sketch of Service Here

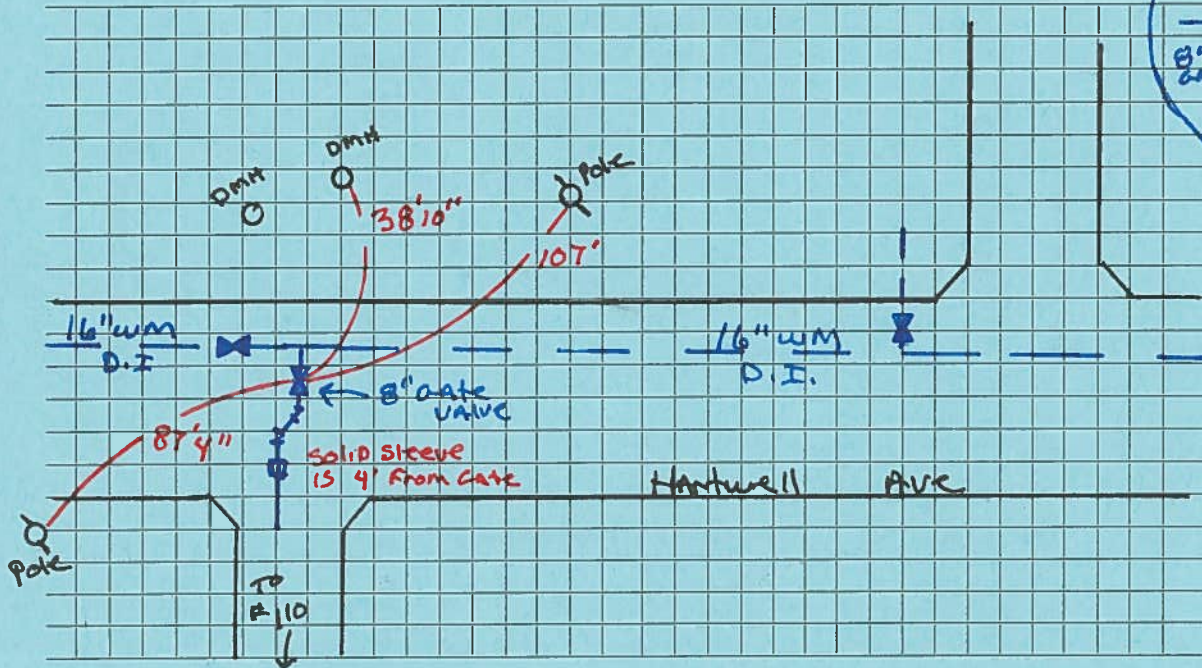

Connection made in Hartwell Ave Street. Work completed

Remarks:

.....

.....

