
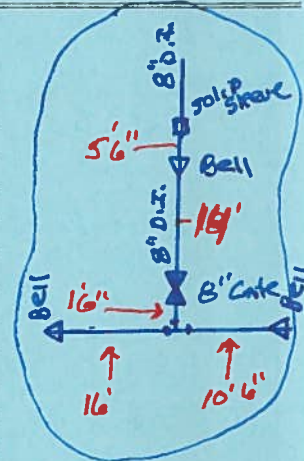


DATE 10/15/2019

TOWN OF LEXINGTON — BOARD OF PUBLIC WORKS

WATER DIVISION

Sketch of Service Here

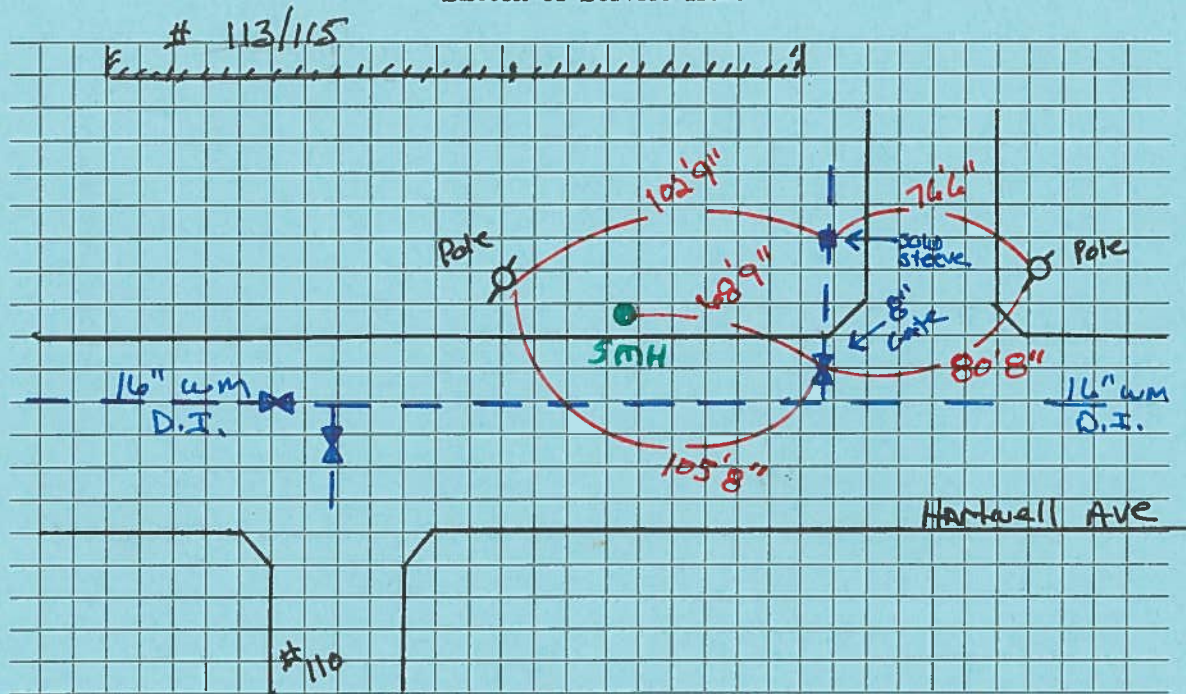

Connection made in Hartwell Ave Street. Work completed .....

Remarks: .....

.....

.....

