


DATE _____

TOWN OF LEXINGTON — BOARD OF PUBLIC WORKS
WATER DIVISION

Sketch of Service Here

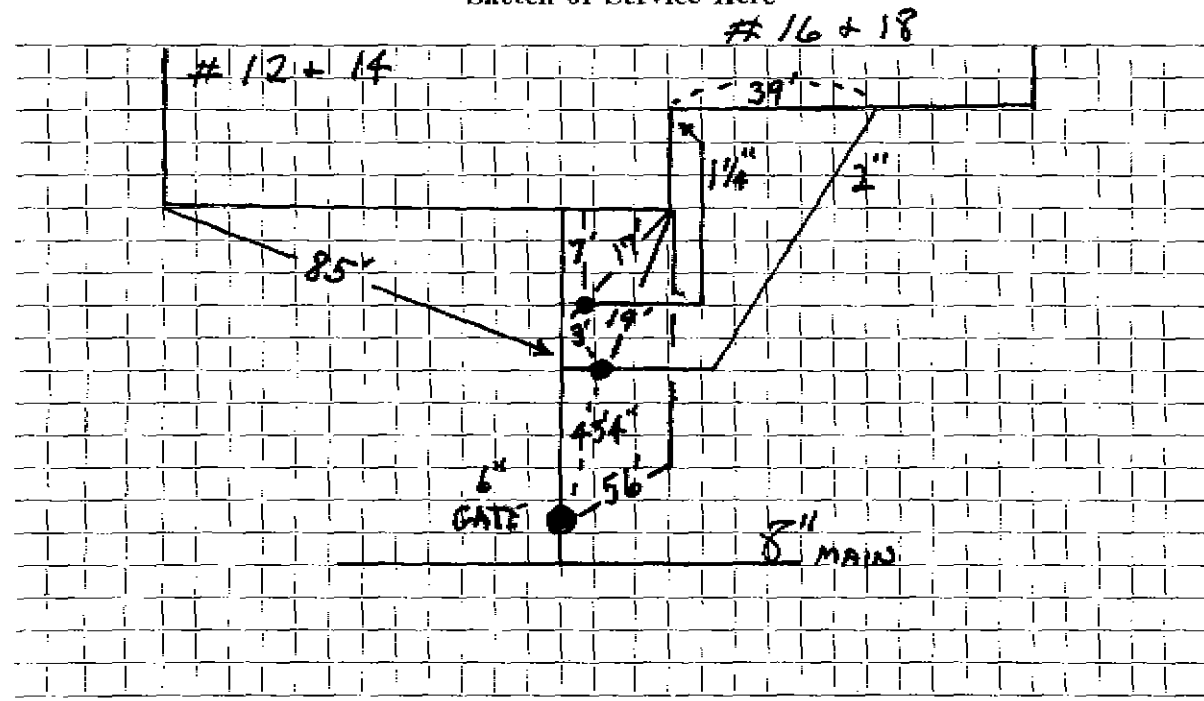

Connection made in Street. Work completed

Remarks: 1 1/4" COPPER w/ CURB BOX. 2" COPPER w/ RD WAY BOX