

WATER SERVICE RECORD

Name MICO REALTY TRUST

Service No. 18

Address 125 HATWELL AVE

Location _____

Repair—Renewal—New Service _____

SEPT 15-1979


Date	Material	Amount	Total	Date	Amount
8-15	79 6" DIP 2" COPPER 2" TEE HEAD CURB				
9-26	90 CONT. WOOD ST 1 6" GATE 12X6 TEE 6" 45°				

DATE _____

TOWN OF LEXINGTON — BOARD OF PUBLIC WORKS

WATER DIVISION

Sketch of Service Here
CUB 3'9" out From Buld

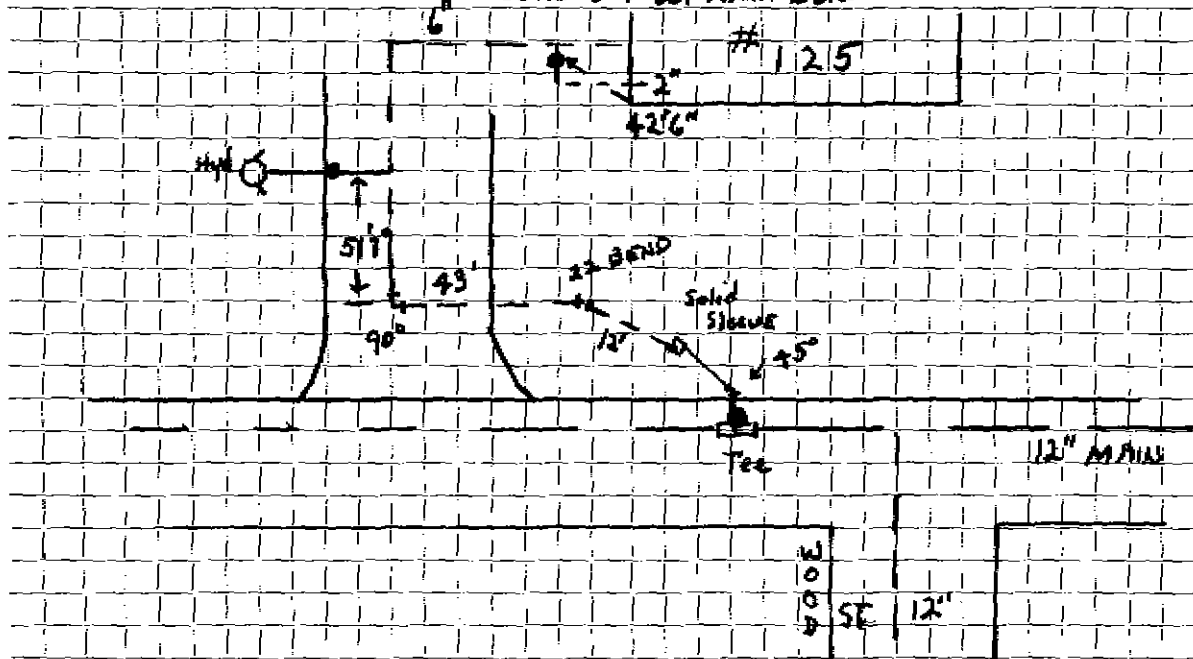

Connection made in Street. Work completed

Remarks:
.....
.....