


DATE 10-16-81

TOWN OF LEXINGTON — BOARD OF PUBLIC WORKS

WATER DIVISION

Sketch of Service Here

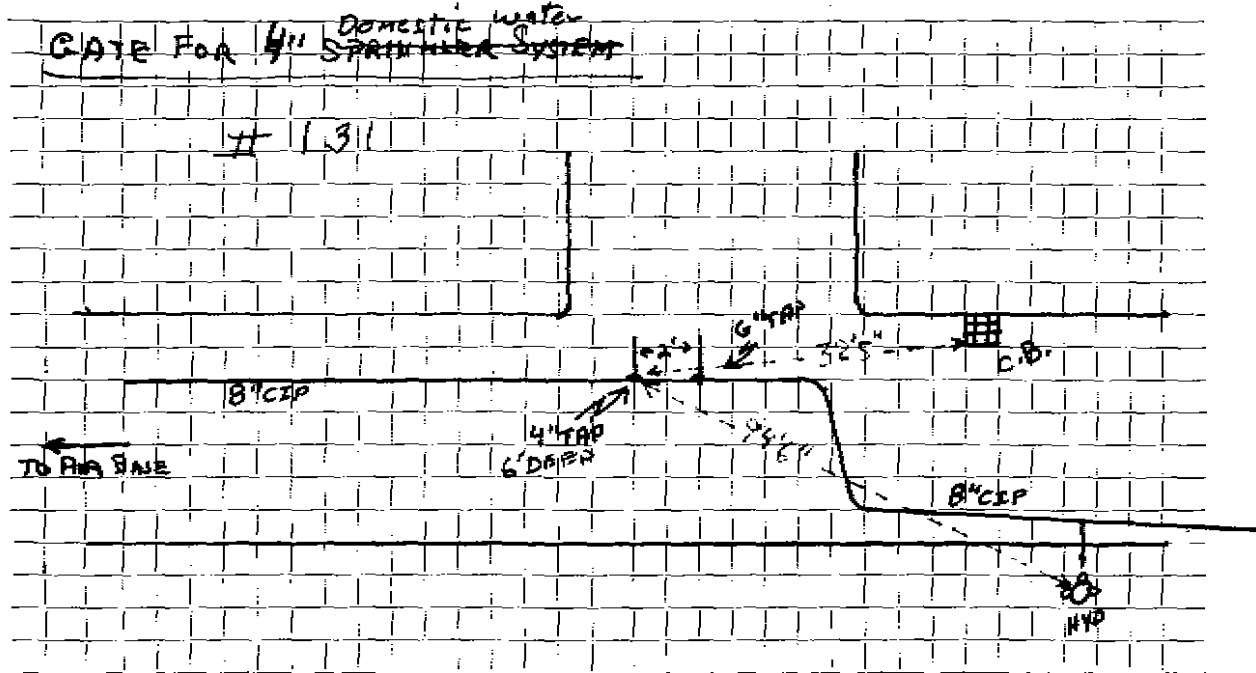


Connection made in HARTWELL AVE Street. Work completed

Remarks 2\" TAPPING SLEEVE AND GATE — 6\" TAP 25\" TO THE RIGHT

DATE 10-16-81

TOWN OF LEXINGTON — BOARD OF PUBLIC WORKS
WATER DIVISION

Sketch of Service Here

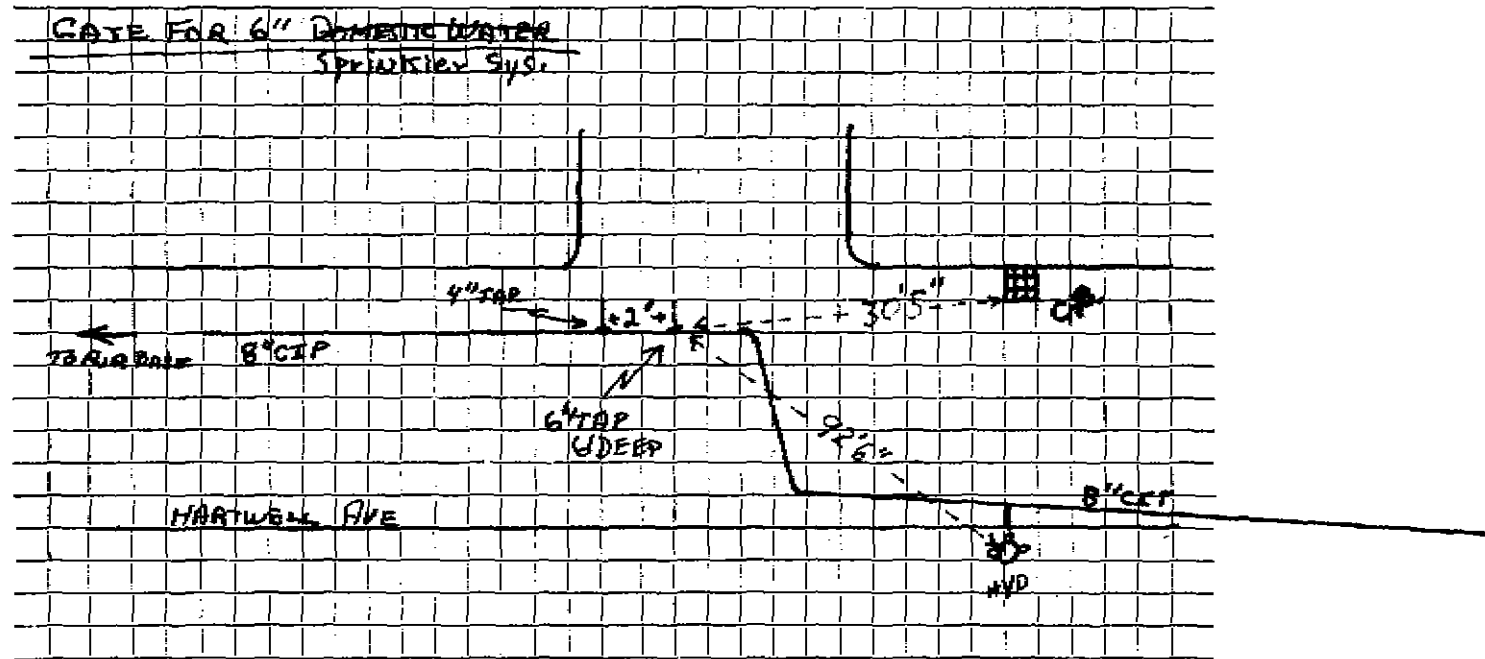

Connection made in HARTWELL AVE Street. Work completed

Remarks 6" TAPPING SLEEVE AND GATE - 4" TAP 95" TO THE LEFT