


TOWN OF LEXINGTON — BOARD OF PUBLIC WORKS

WATER DIVISION


Sketch of Service Here

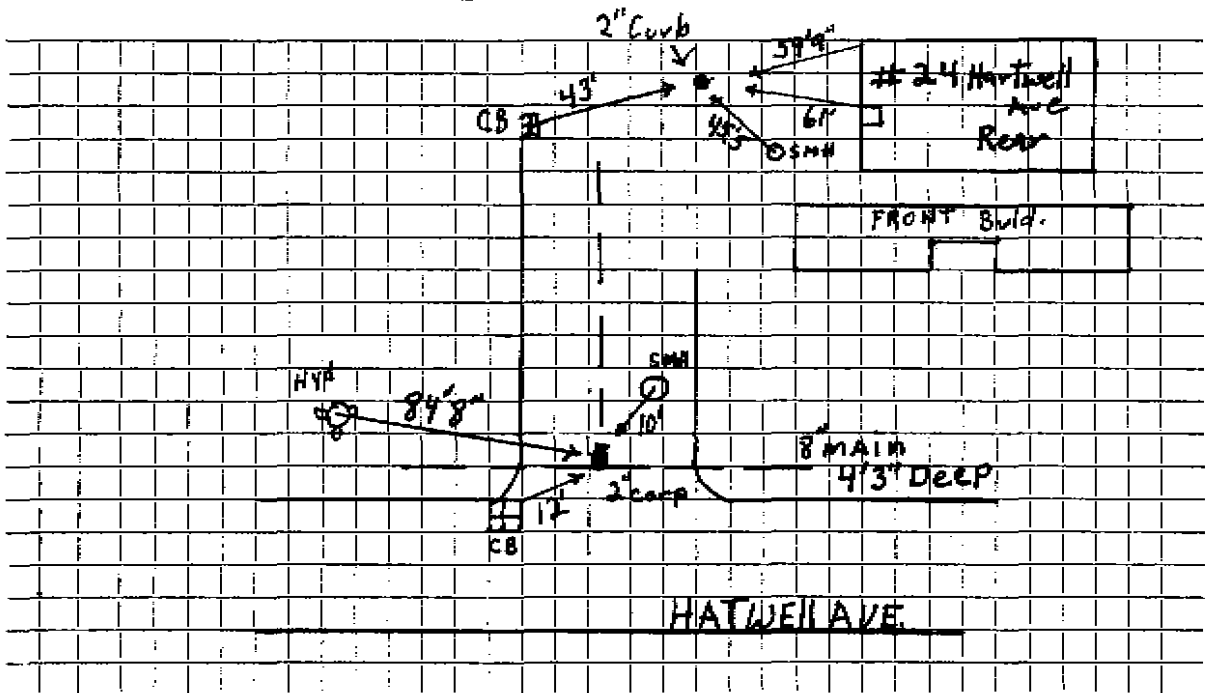

Connection made in Driveway 8" main 8 1/2" saddle Street. Work completed

Remarks: Service was not inspected never called. Osley Corp + saddle


Hartwell Ave

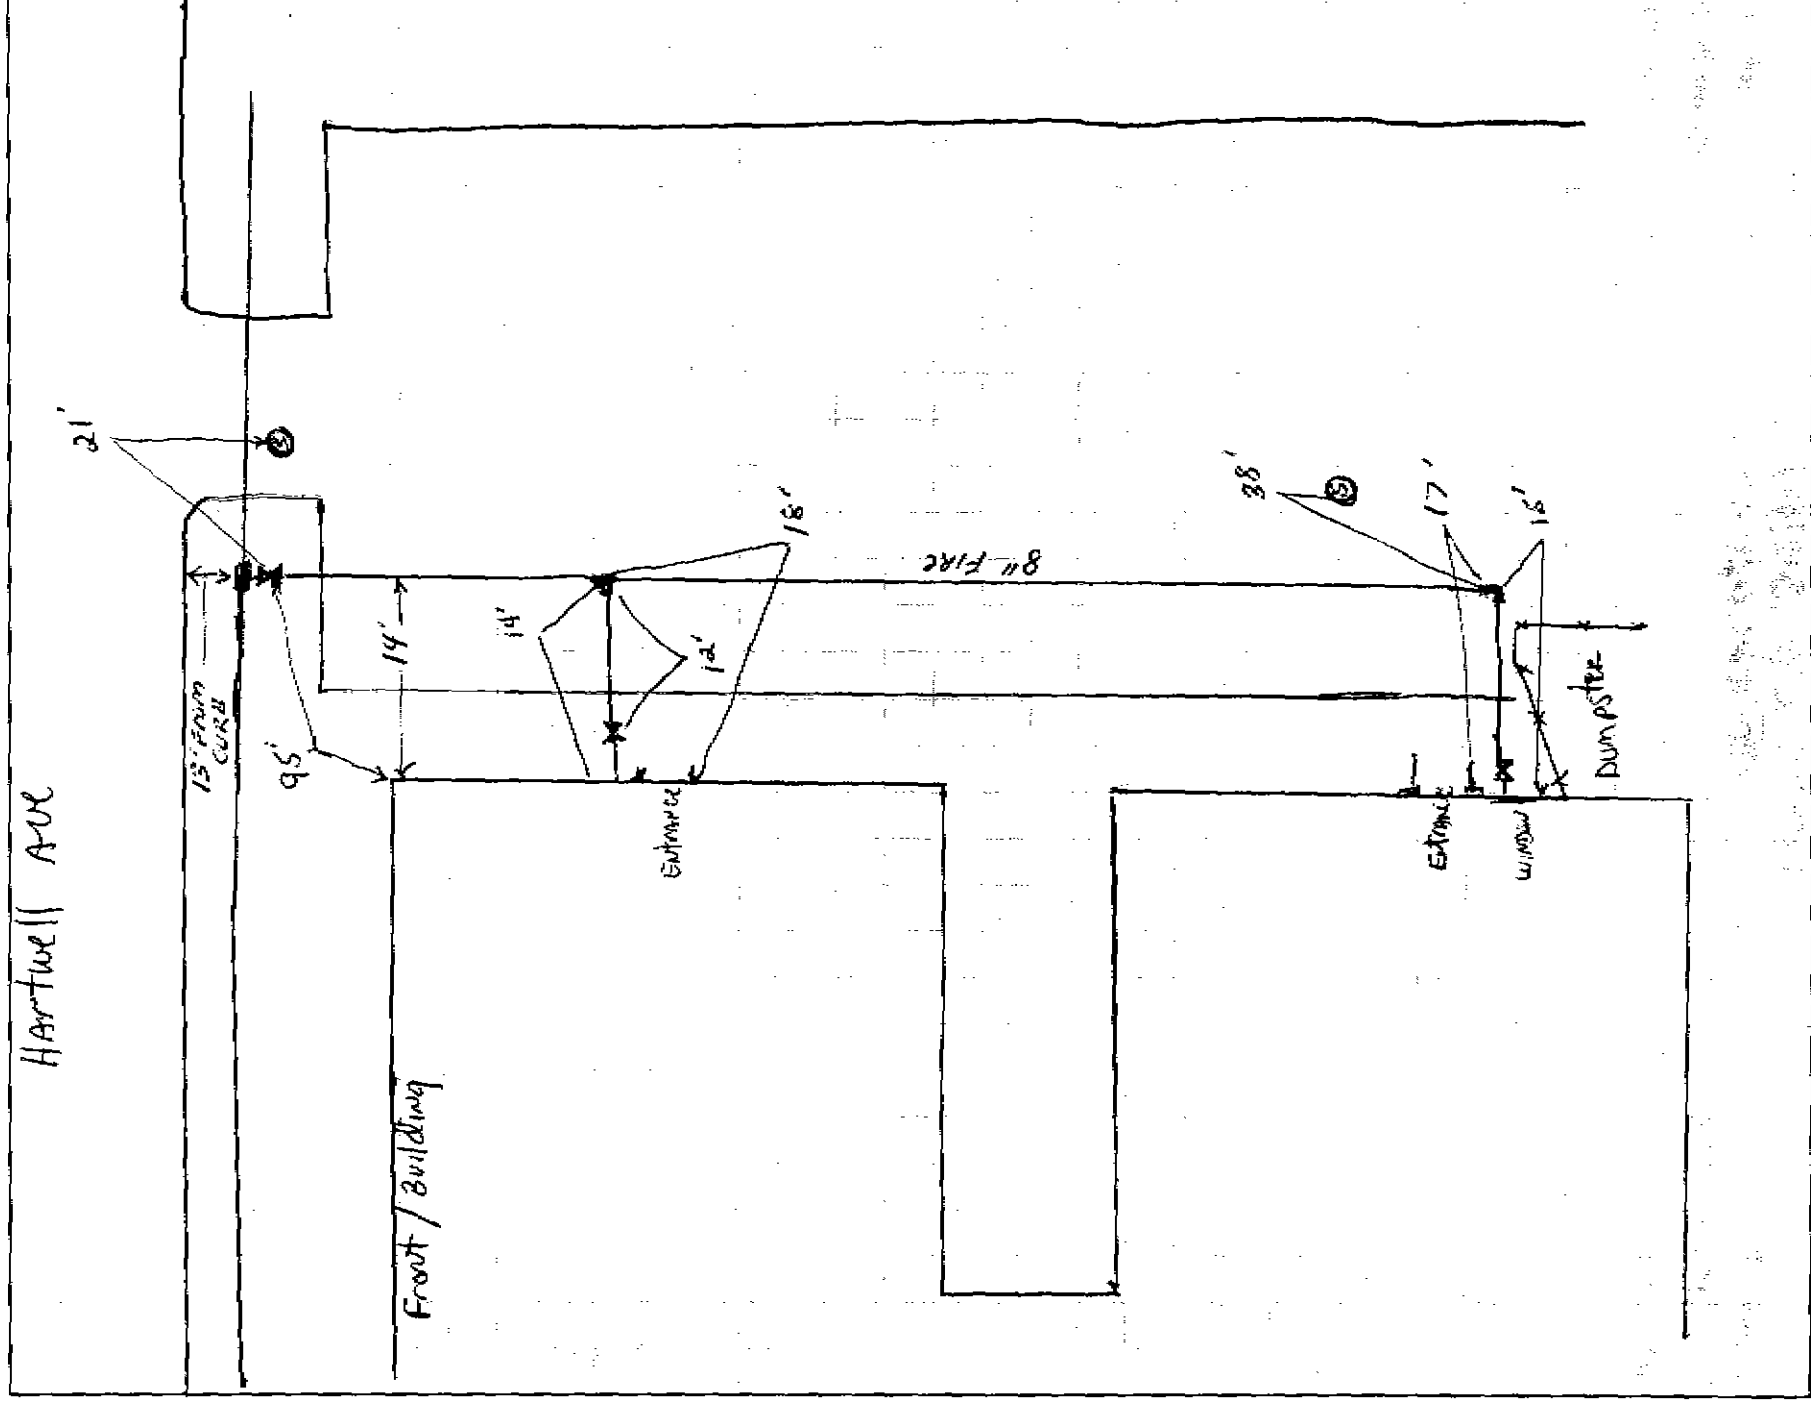

DATE _____

TOWN OF LEXINGTON — BOARD OF PUBLIC WORKS
WATER DIVISION

Sketch of Service Here

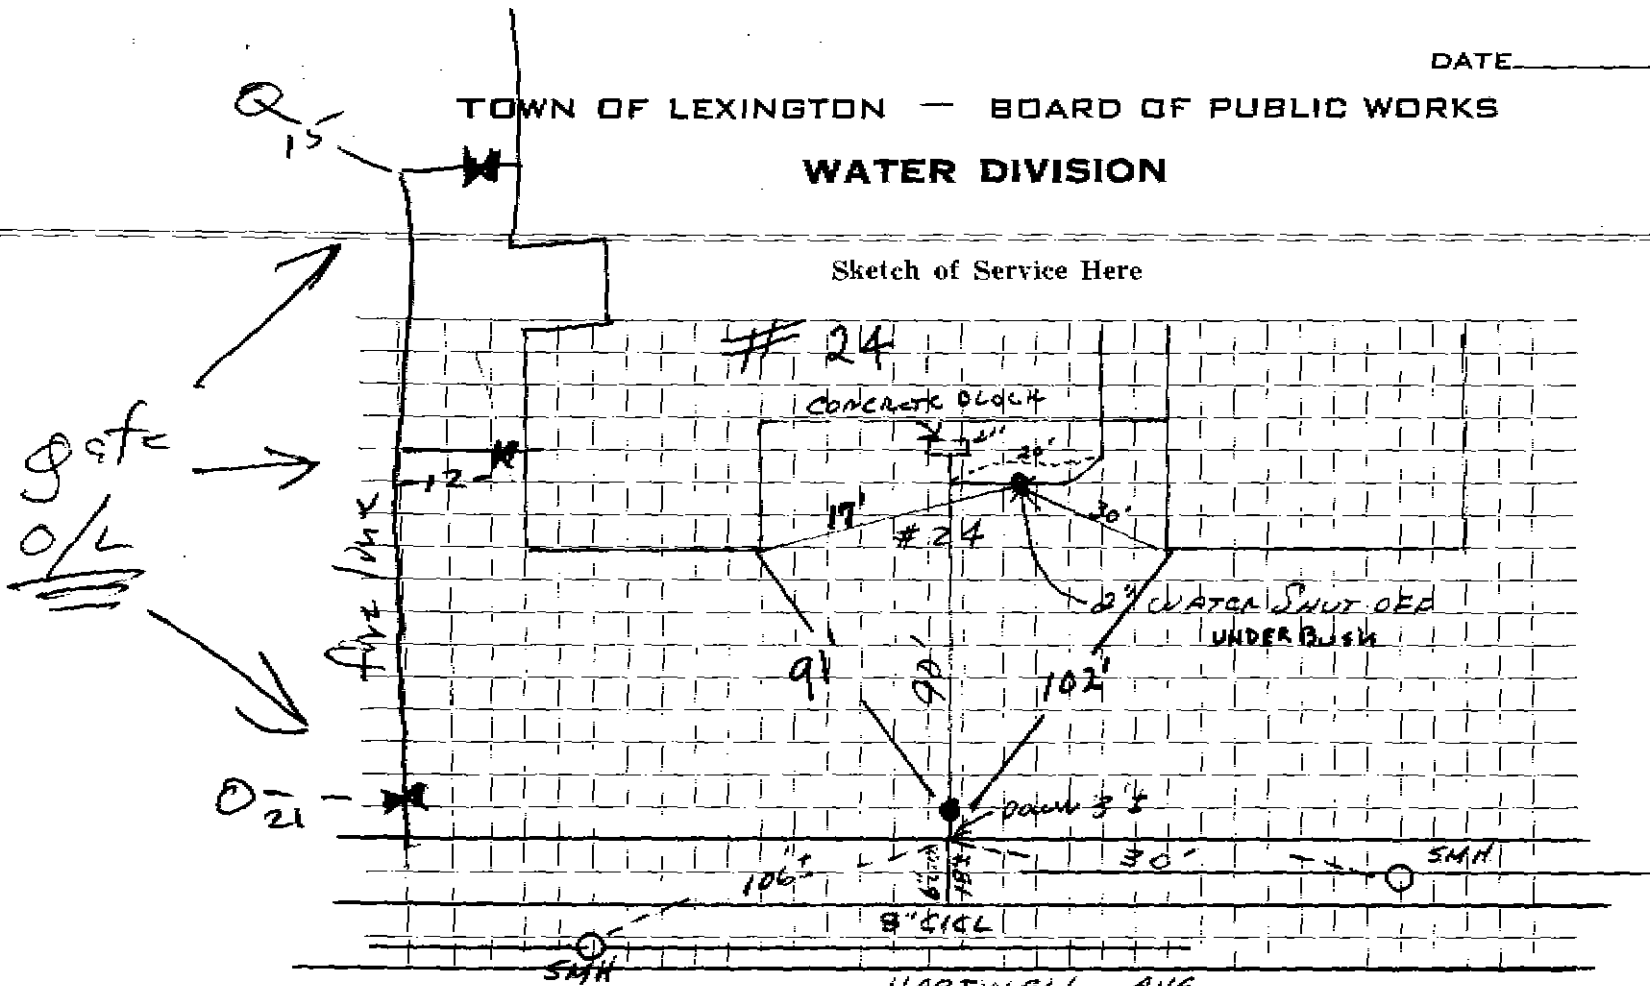

Connection made in _____ Street. Work completed _____

Remarks: gate open left on fire line