

WATER SERVICE RECORD

#5020

Name Mice Realty Corp.Service No. 12Address #29 Hartwell AveLocation # 29 Hartwell AvenueRepair—Renewal—New Service W.O. # 7627 Bonanno #1560**JUL 27 1970**


Date	Material	Amount	Total	Date	Amount	
4/28/70	Labor	32.97		4-27-70	Deposit	350.00
	10% O.H.	3.30	36.27			
	40' 2" Copper pipe 2.00		80.00			
	1 2" Corporation		36.60			
	1 12"x2" Tapped Saddle		18.48			
	1 2" Curb Cock		55.65			
	1 Rd. Box		17.00			
	2 Hrs. trucking 3.00		6.00			
			250.00			
5-7-70	125' 2" Copper tubing					

DATE _____

TOWN OF LEXINGTON -- BOARD OF PUBLIC WORKS

WATER DIVISION

Sketch of Service Here

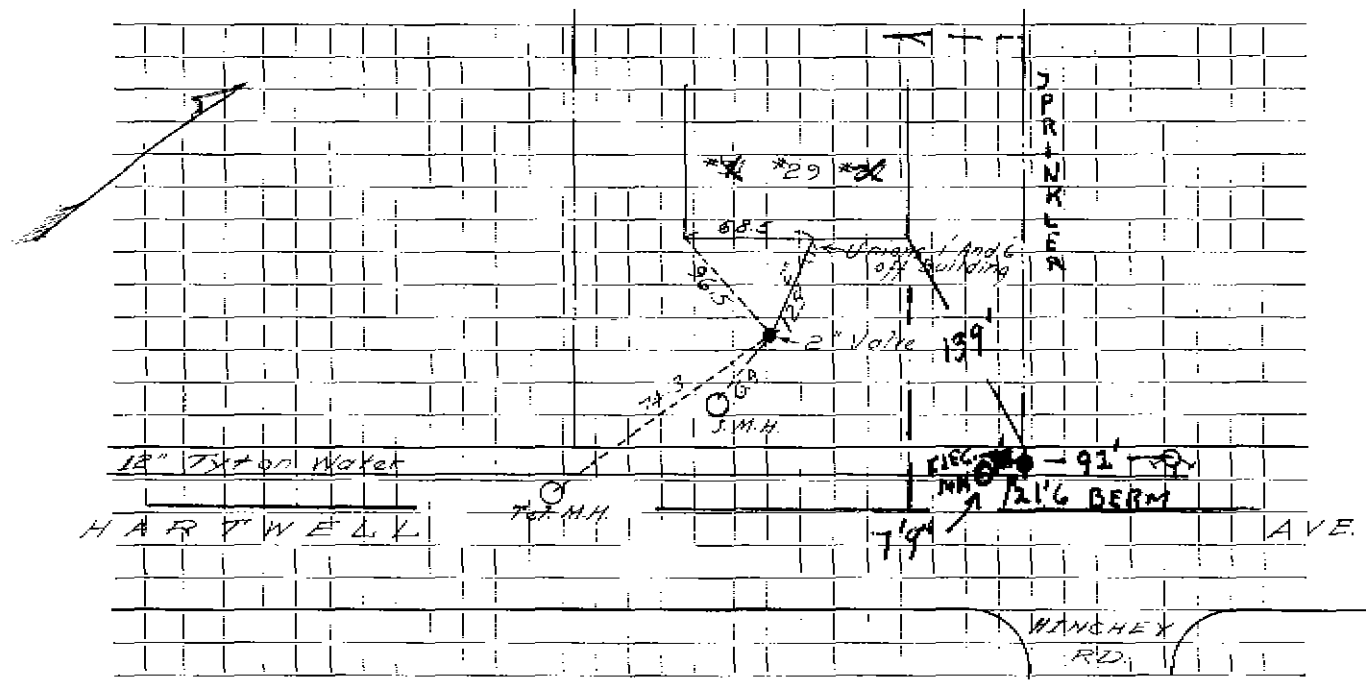

Connection made in Street. Work completed

Remarks: GATE BOX IN BUSHES TO RIGHT OF DRAINWAY


.....
.....

29 Hartwell Ave

DATE 12/21/01

TOWN OF LEXINGTON — BOARD OF PUBLIC WORKS
WATER DIVISION

Sketch of Service Here

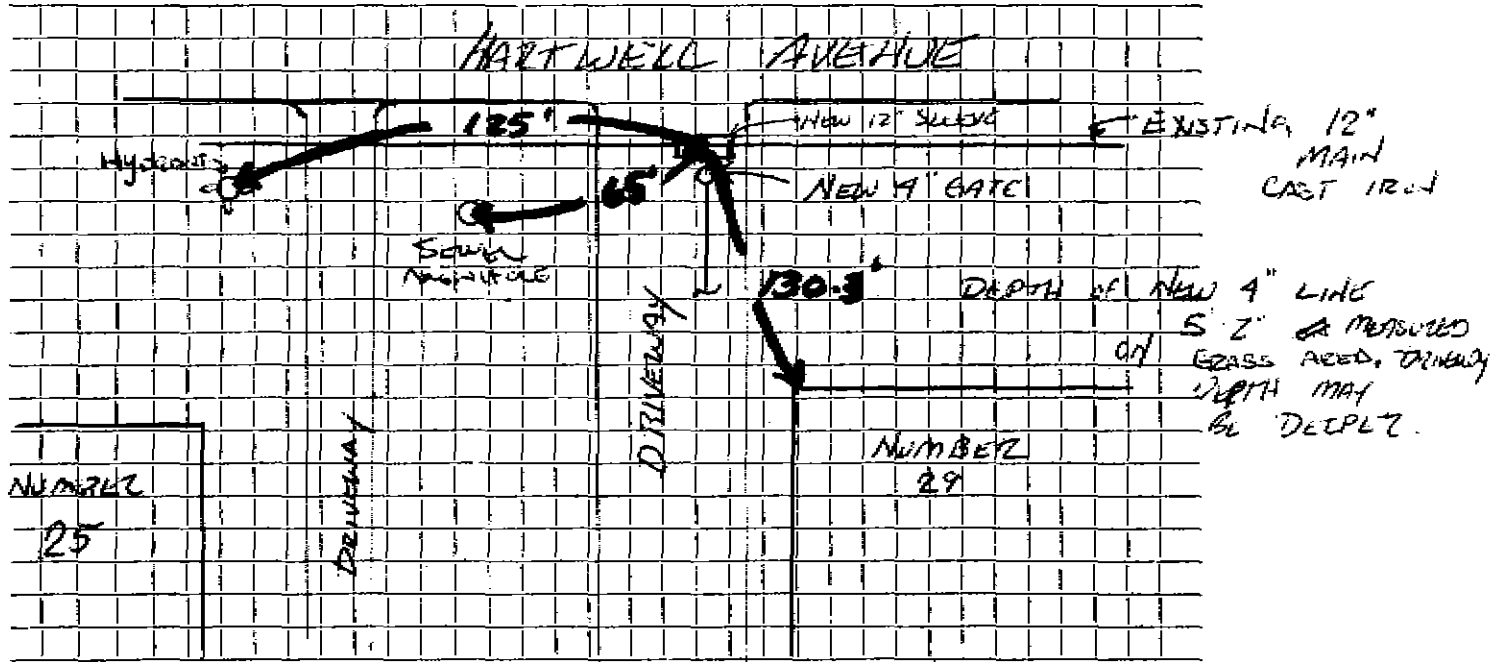

Connection made in Street. Work completed

Remarks: TAP & SLEEVE Done By SOUTH SHORE PIPELINE FOR NEW 4" CIDL

DOMESTIC SERVICE to 29 HARTWELL AVE