

WATER SERVICE RECORD

Name Abathaw Const. Co. - *Calyse Engineering*

Service No. 53

Address 32 Hartwell Avenue

Location

Repair—Renewal—New Service W.O.#5328 Hewlett Pakard #822

MAR 18 1968


Date	Material	Amount	Total	Date	Amount
1967	200' 2" Copper tubing			8-16-67	750 00
8/16/67	Labor 50x92	50 92		3-18-68	171 86
8/30/67	Labor	121 97			578 14
9/1/67	Labor	89 28			
11/10/67	Labor	23 18			
11/10/67	Labor	33 00			
		318 35			
	10% O.H.	31 84	350 19		
	8x12 off set		55 00		
	75 lbs. mineral lead		9 75		
	40 lbs. jute		31 20		
	8" off set with 6" drop		49 00		
	9 hrs. shovel		58 50		
	4½" trucking		13 50		
	1" compressor		5 00		
	2" roller		6 00		
			578 14		

DATE _____

TOWN OF LEXINGTON — BOARD OF PUBLIC WORKS

WATER DIVISION

Sketch of Service Here

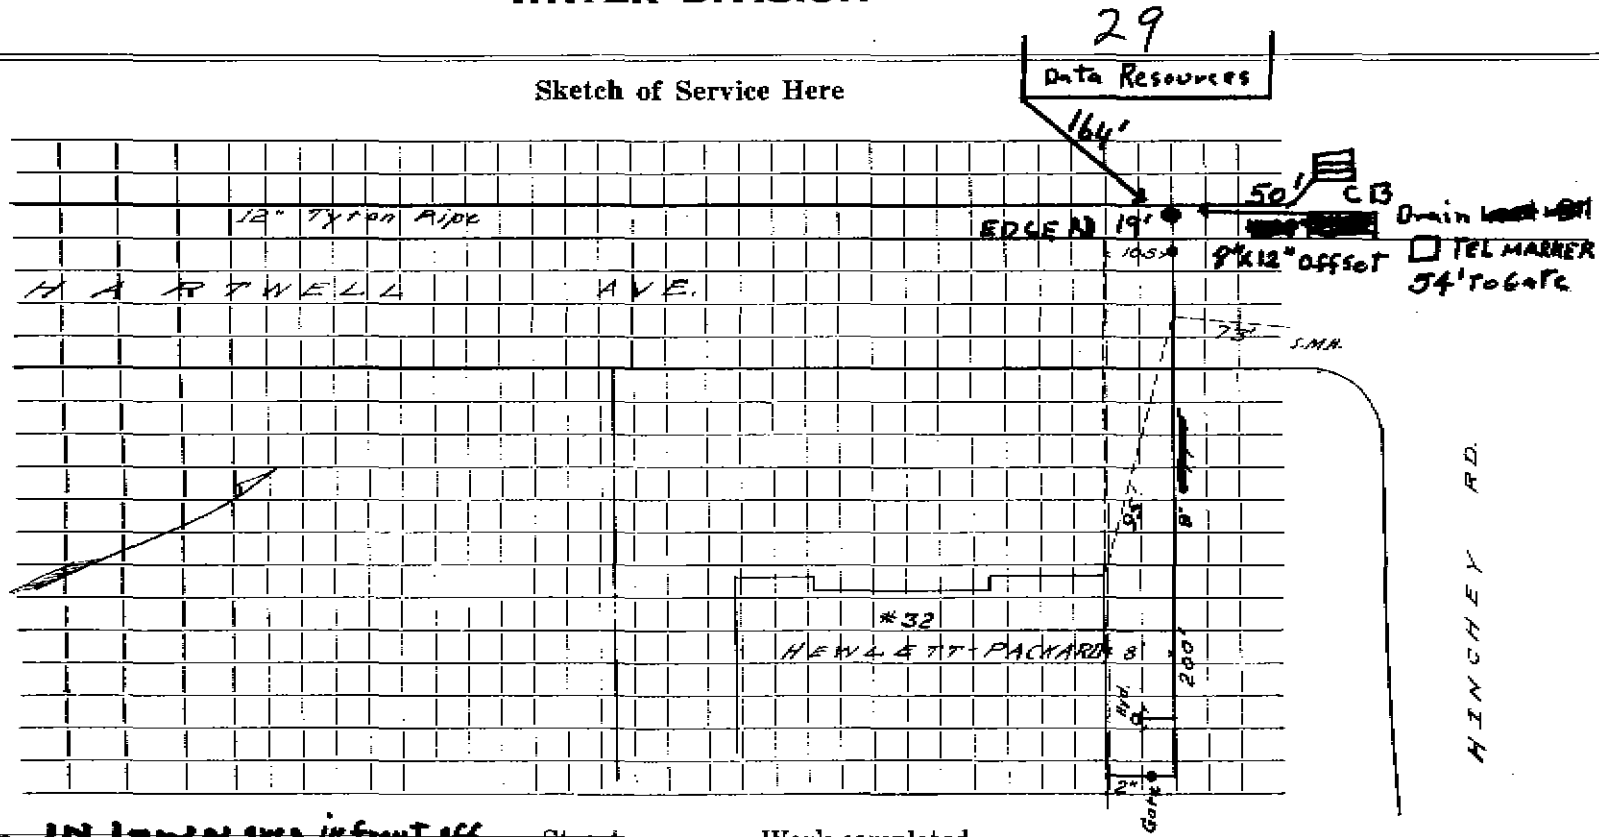

Connection made in IN TRENCH OVER IN FRONT OFF Street. Work completed

Remarks: Data Resources

.....
.....