

WATER SERVICE RECORD

Name Donald M. Manzelli

Service No. 73

Address 35 Hartwell Avenue

Location TAP SLEEVE + GATE FOR SPRINKLER

Repair - Renewal - New Service W. O. # 220 - Relocation of Hydrant


MAY 29 1973

Date	Material	Amount	Total	Date	Amount
12/14/72	Labor Relocate Hyd	137 04		10-27-73	300 00
	10% O.H.	13 70	150 74	5-29-73	34 94
18'	6"-M.J. Water pipe	2.60	46 80		265 04
1	6"-M.J. 90o Elbow		41 10		
5	Lbs. Mineral lead		90		
2	Hrs. truck 3.00		6 00		
3	Hrs. Shovel 6.50		19 50		
	SERVICE FOR Buld		265 04		
11-13-72	TAP SLEEVE + GATE	210.93			

TOWN OF LEXINGTON — BOARD OF PUBLIC WORKS

WATER DIVISION

Sketch of Service Here

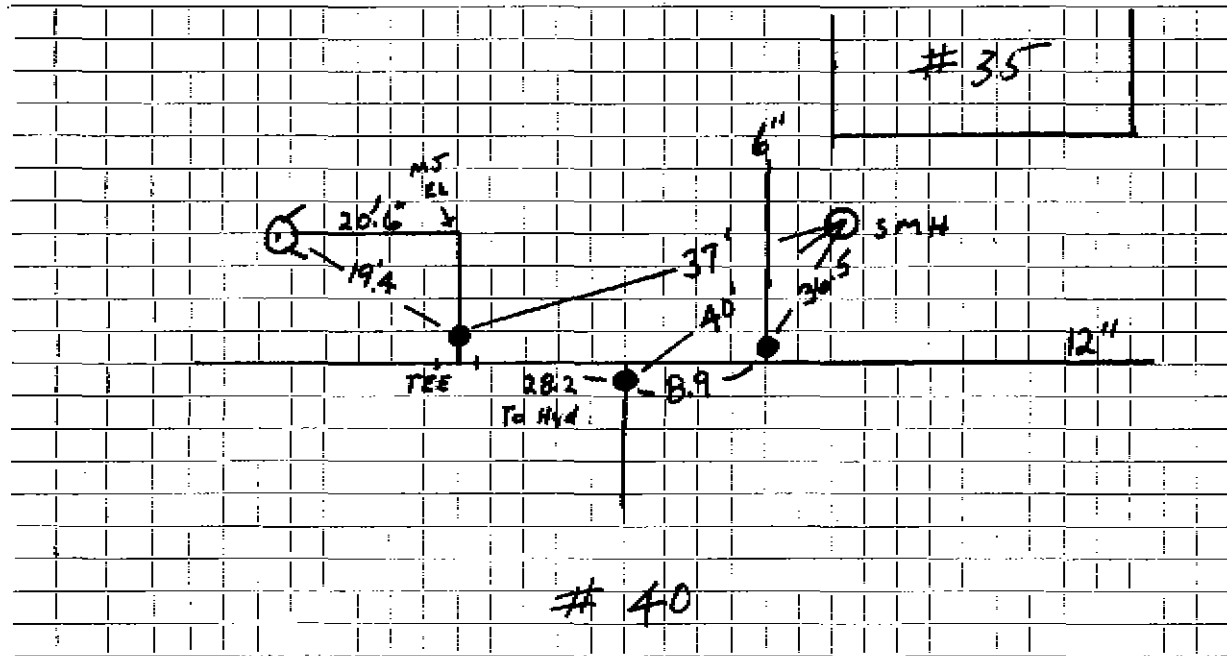

Connection made in Street. Work completed

Remarks:

.....

.....