




DATE \_\_\_\_\_

TOWN OF LEXINGTON — BOARD OF PUBLIC WORKS

WATER DIVISION

Sketch of Service Here

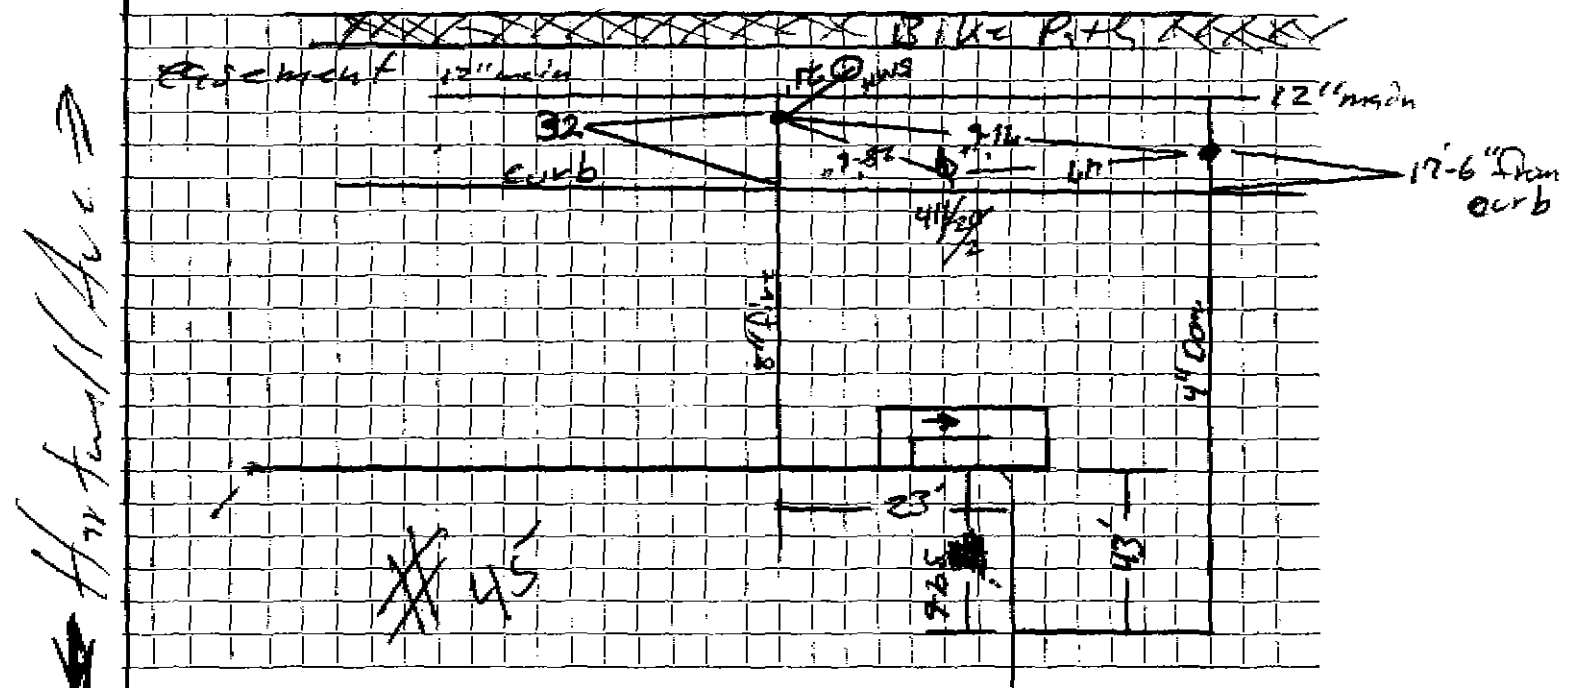

Handwritten note: *Horton Ave* with an arrow pointing to the left side of the grid.

Connection made in \_\_\_\_\_ Street. Work completed \_\_\_\_\_

Remarks: *Water on easement. Two lots one for fire one for building*