


DATE 8-22-2019

TOWN OF LEXINGTON — BOARD OF PUBLIC WORKS

WATER DIVISION

Sketch of Service Here

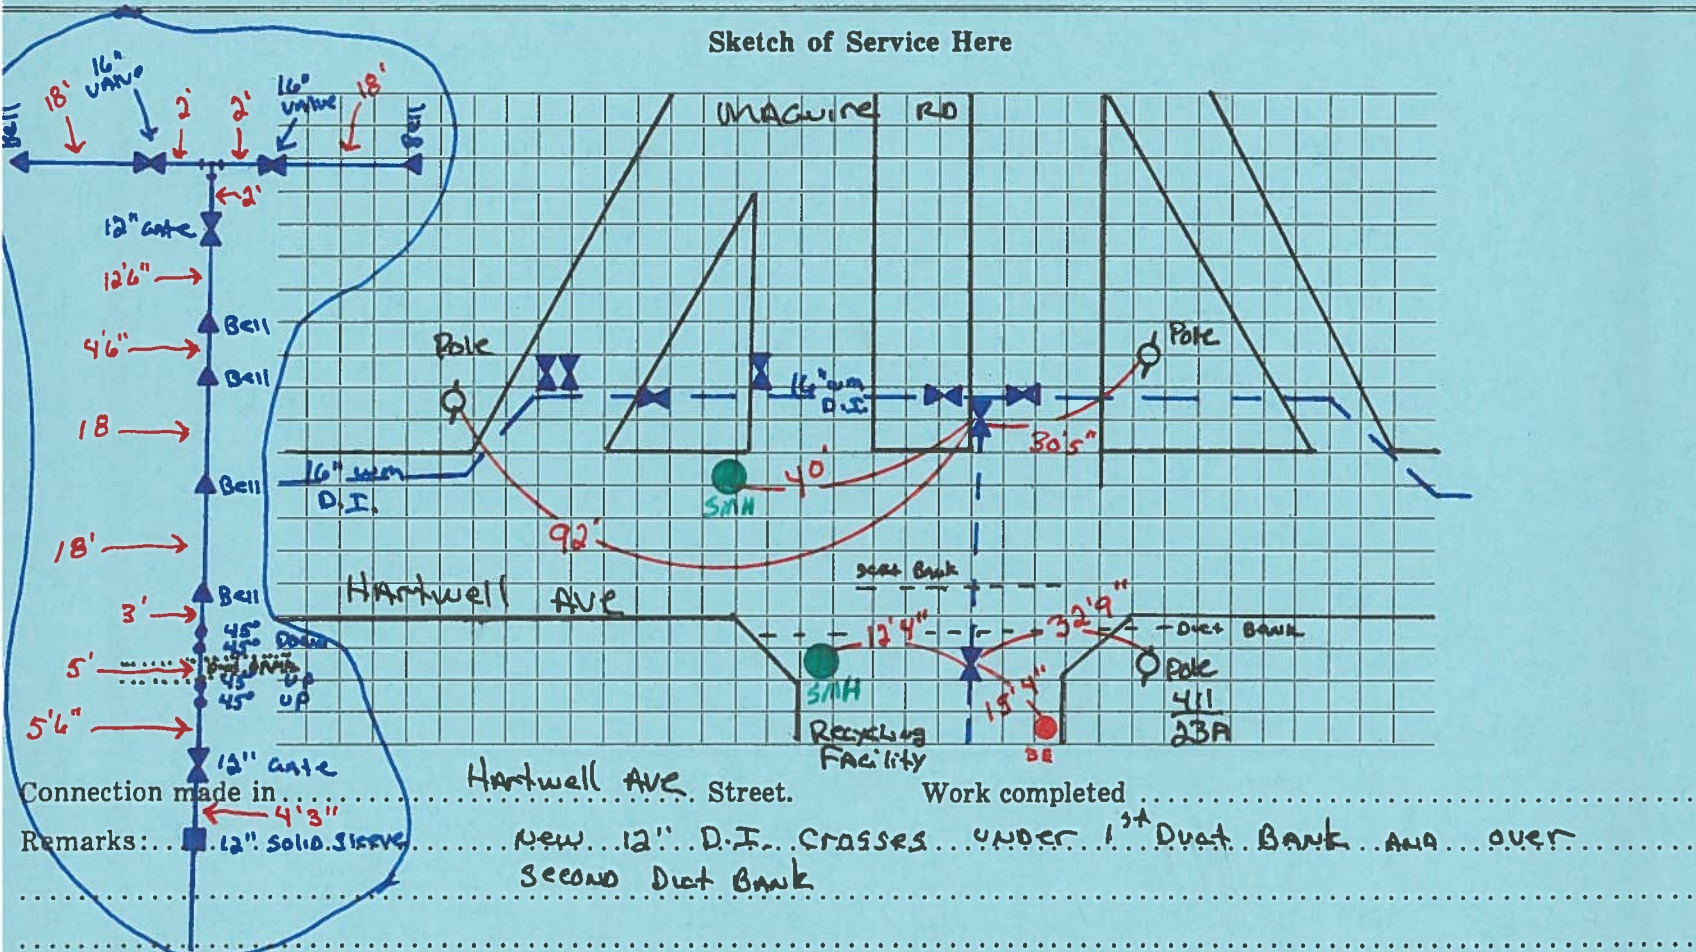

Connection made in 4'3" 12" solid sleeve

Remarks: .. New 12" D.I. crosses under 1<sup>st</sup> Duct Bank and over second Duct Bank

Hartwell Ave. Street. Work completed under 1<sup>st</sup> Duct Bank and over second Duct Bank

