

WATER SERVICE RECORD

Name Depositer' Trust Company (Arlex Oil Corp.)

Service No. 26

Address 7 Hartwell Avenue

Location

~~REPAIR~~ ~~REVISION~~ — New Service Dave Eagle #3447

DEC 3 1979


| Date | Material | Amount | Total | Date | Amount |
|----------|----------------------------|--------|--------|----------|---------------|
| 10-24-79 | Labor | 105.72 | | 10-16-79 | 330.00 |
| | 10% O.H. | 10.57 | 116.29 | | 10.25 |
| | 25' 1" Copper tubing @ .90 | | 22.50 | | 309.18 |
| | 1 1" Corp. | | 19.65 | | |
| | 1 1" Curb | | 24.18 | | |
| | 1 Box & Rod | | 10.95 | | |
| | 2 hrs. Trucking @3.00 | | 6.00 | 5/30/80 | 25' 1" Copper |
| | 2½ hrs. Backhoe @6.50 | | 16.25 | | |
| | Hot Top 20' x 7' | | 93.36 | | |
| | | | 309.18 | | |
| 5/30/80 | 72' 1" Copper tubing | | | | |

*Pipelay
Return*

OUTSIDE

TOWN OF LEXINGTON — BOARD OF PUBLIC WORKS
WATER DIVISION

Sketch of Service Here

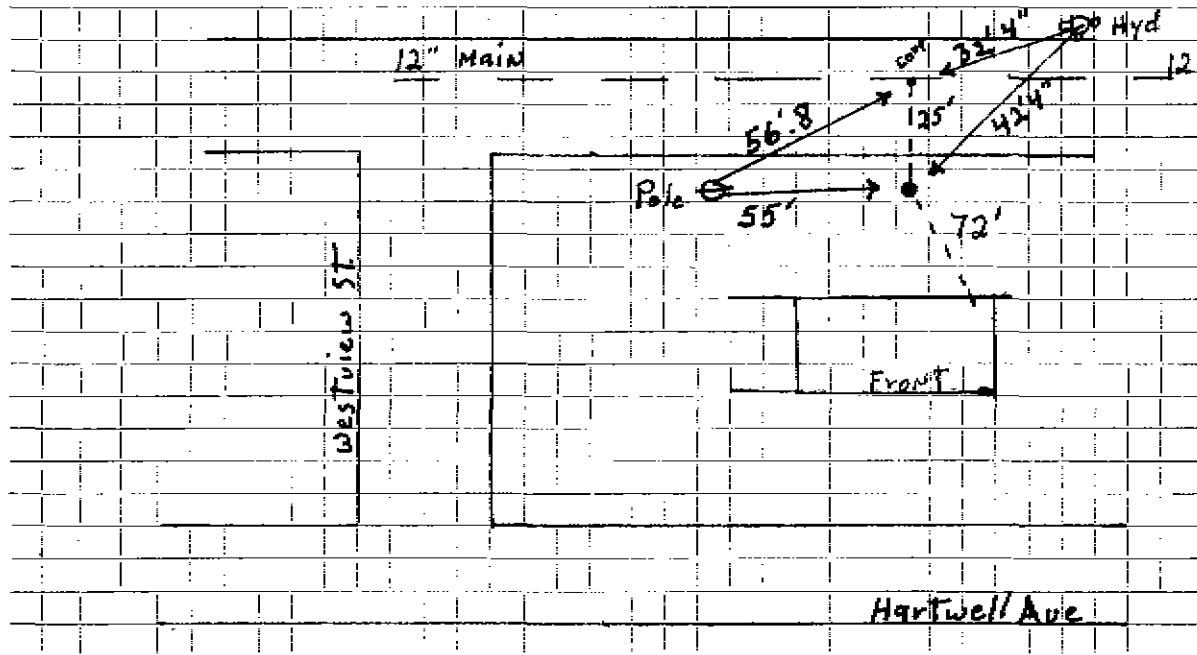

Connection made in Street. Work completed

Remarks:

.....

.....