




DATE \_\_\_\_\_

TOWN OF LEXINGTON — BOARD OF PUBLIC WORKS  
WATER DIVISION

Sketch of Service Here

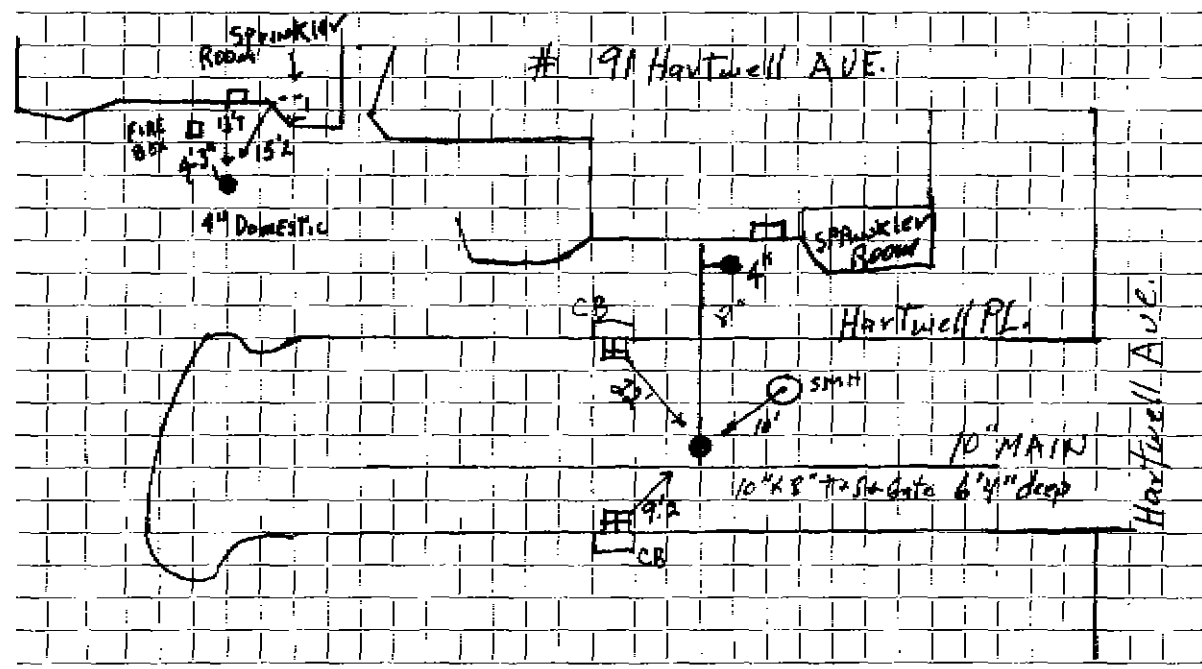

Connection made in Hartwell P.L. Street. Work completed

Remarks: 1" is off 8" MAIN